22468

IREDELL COUNTY HEALTH DEPARTMENT

STATESVILLE 704-878-5305 MOORESVILLE 704-664-5281

IMPROVEMENT PERMIT / CERTIFICATE OF COMPLETION / OPERATION PERMIT / EXISTING SYSTEM INSPECTION

PROPERTY DESCRIPTION NO 22468 DATE 11-20-95 TAX MAP NO 8M-9-A-1 Watershed: ☐ Yes ☑ No

OWNER OR CONTRACTOR ERNEST H. RUNGE PHONE: Business _____ Home 872-6645

ADDRESS 374 LONG ISLAND ROAD, STATESVILLE NC 28677

LOCATION I-40 W, TR OLD MOUNTAIN ROAD, TR CONIFER DRIVE, 1ST LOT ON LEFT (AT PINE BARK COURT)

SUBDIVISION PINE RIDGE ESTATES BLOCK / SECTION _____ LOT 1 LOT AREA 0.564 AC SITE CLASS P3 DESIGN FLOW 360 L.T.A.R. 0.30 GPD/FT²

Septic Tank: 1000 Gallons; STB 1012 Date 4-28-96
Pump Tank: _____ Gallons; PT _____ Date _____
Pump Make: _____ Model _____ Serial No. _____
Nitrification Field: No Fields 1 Square Feet 1200 Linear Feet 400
No Lines 4 Trench Width 36" Max Trench Bottom Depth 24"

☑ New System ☐ Repair System Type: I II III IV V VI
System Description: CONVENTIONAL GRAVITY
Repair System Description: CONVENTIONAL GRAVITY
Maintenance Agreement Required: ☐ Yes ☑ No
Gravel Depth 12"


☐ House/Mod. Home No. Bedrooms 3
☑ Mobile Home No. Bathrooms 2
☐ Business No. Employees ___
☐ Other _____
☐ Slab ☑ Crawl Space ☐ Basement w/plumbing ☐ Basement wo/plumbing

Water Supply:
☐ Individual
☐ Community
☑ Public


Comments: ① INSTALL SUBSURFACE INTERCEPT DRAIN ABOVE SYSTEM AS SHOWN ② USE THREE FLOW DIVIDERS TO ACHIEVE EQUAL DISTRIBUTION INTO EACH OF FOUR LINES ③ INSTALL LINES ON CONTOUR NO DEEPER THAN 24 INCHES.

Comments: DRIVEWAY CHANGED TO LEFT SIDE OF M.H.

INITIAL SITE SKETCH

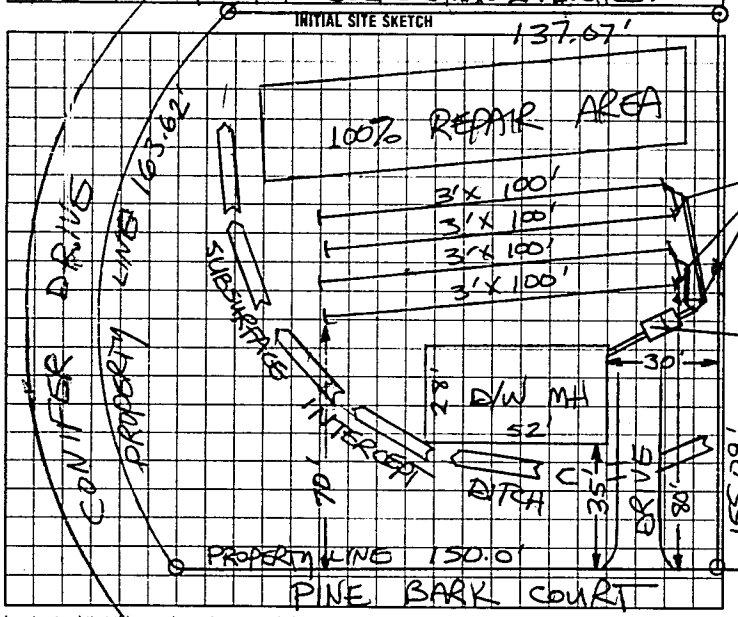

AS BUILT SKETCH

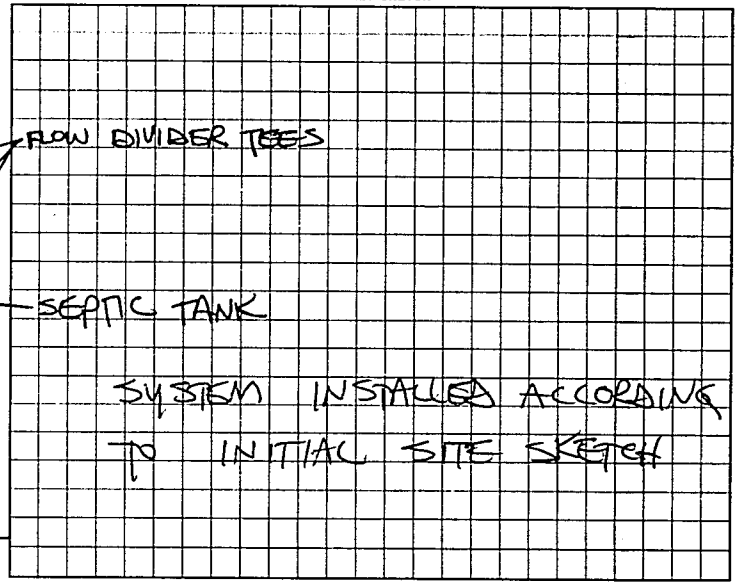

I understand that this permit can be suspended or revoked if any false information is supplied toward securing the permit/any unauthorized changes are made to the site/any unauthorized changes are made in the installation of the system.

AUTHORIZATION TO CONSTRUCT IS VALID FIVE (5) YEARS FROM DATE OF ISSUANCE. IMPROVEMENT PERMIT HAS NO EXPIRATION

Signed: _____

Improvement Permit by: STEVE HEDRICK date 11-20-95

AUTHORIZATION TO CONSTRUCT Inspection by: STEVE HEDRICK date 4-10-96

Installed by: FORREST STAFFORD / RICK SNOOK DATE,

Certificate of Completion by: _____ date _____

Operation Permit by: STEVE HEDRICK date 7-25-96

HEALTH DEPT COPY WHITE | INSPECTION COPY (FINAL) GREEN | OWNER COPY (FINAL) YELLOW | INSPECTION COPY (INITIAL) PINK | OWNER COPY (INITIAL) GOLD

00203 4