59224

# IREDELL COUNTY HEALTH DEPARTMENT

STATESVILLE 704-878-5305 MOORESVILLE 704-664-5281

## IMPROVEMENT PERMIT / CERTIFICATE OF COMPLETION / OPERATION PERMIT / EXISTING SYSTEM INSPECTION

PROPERTY DESCRIPTION NO. 22963 DATE 2-6-96 TAX MAP NO 8M-9-A-5 Watershed: Yes No

OWNER OR CONTRACTOR SUNWOOD BUILDING PHONE: Business 872-0922 Home

ADDRESS P.O. BOX 5877 STATESVILLE, NC 28687

LOCATION I-40 W. TR OLD MTN. RD TR CONIFER DRIVE, TL PINE BARK COURT 1ST LOT on (R)

SUBDIVISION PINE RIDGE BLOCK / SECTION LOT 5 LOT AREA 0.587 ACRES SITE CLASS PS DESIGN FLOW 360 L.T.A.R. 0.30 GPD/FT²

Septic Tank 1000 Gallons; STB 1010 Date 11/22/95
Pump Tank Gallons; PT CUL-A-SAK Date
Pump Make Model Serial No
Nitrification Field; No Fields 1 Square Feet 1200 Linear Feet 400
No Lines 4 Trench Width 36" Max Trench Bottom Depth 18-36" Gravel Depth 12"

✓ New System Repair System Type: I II III IV V VI
System Description: CONVENTIONAL GRAVITY
Repair System Description: LPP REPAIR
Maintenance Agreement Required Yes ✓ No
Slab ✓ Crawl Space Basement w/plumbing Basement wo/plumbing


✓ House/Mod. Home No. Bedrooms 3
✓ Mobile Home No. Bathrooms 2
Business No. Employees
Other

Water Supply:
Individual
Community
✓ Public


Comments:
① INITIAL SYSTEM ON LOT #6 EASEMENT
② USE FLOW DIVIDER TEES FOR DISTRIBUTION.

Comments: Trench #2 is 163' long, Trench #3 is 166' long.

INITIAL SITE SKETCH

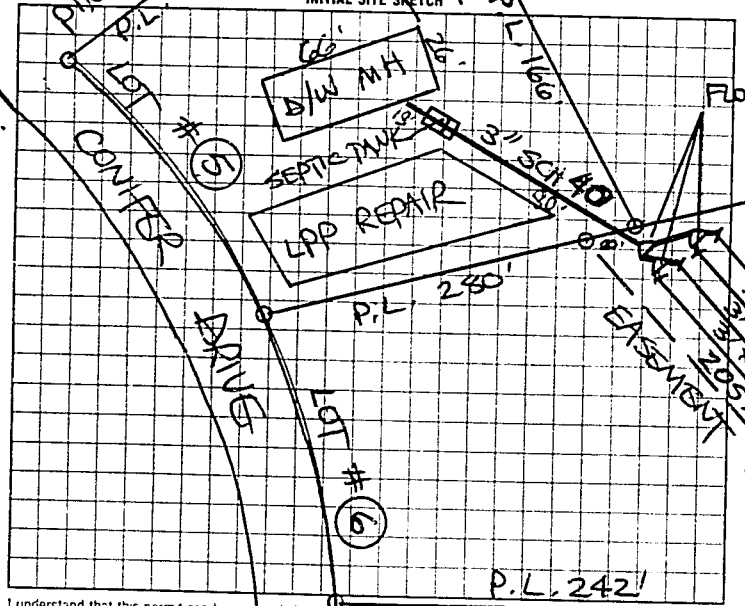


AS BUILT SKETCH

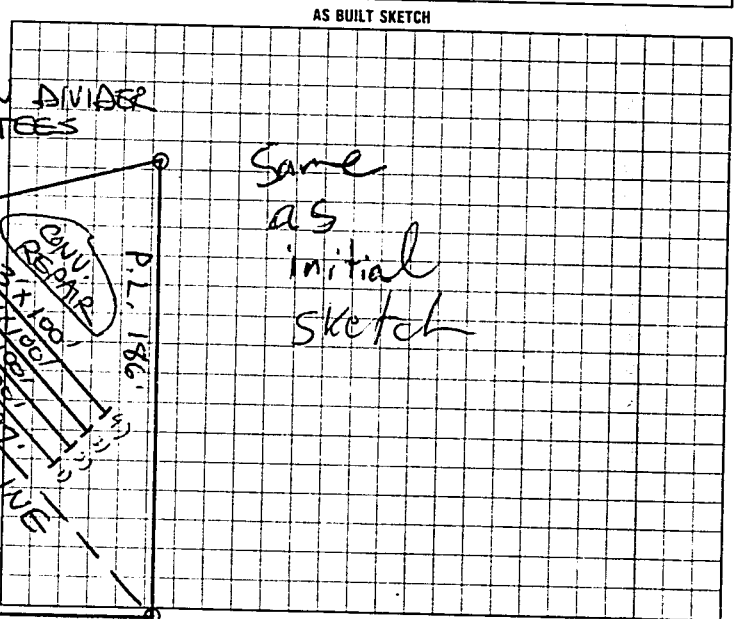


I understand that this permit can be suspended or revoked if any false information is supplied toward securing the permit; any unauthorized changes are made to the site/any unauthorized changes are made in the installation of the system.

AUTHORIZATION TO CONSTRUCT IS VALID FIVE(5) YEARS FROM DATE of ISSUANCE. IMPROVEMENT PERMIT HAS NO EXPIRATION DATE.

Signed

Permit by STEVE HENDRICK date 2-6-96 Installed by

CONSTRUCT STEVE HENDRICK date 2-6-96 Certificate of Completion by date

Operation Permit by Brady Lemmon date 2/19/96

INSPECTION COPY (FINAL) GREEN OWNER COPY (FINAL) YELLOW INSPECTION COPY (INITIAL) PINK