IREDELL COUNTY HEALTH DEPARTMENT

STATESVILLE 704-878-5305 MOORESVILLE 704-664-5281

IMPROVEMENT PERMIT / CERTIFICATE OF COMPLETION / OPERATION PERMIT / EXISTING SYSTEM INSPECTION

PROPERTY DESCRIPTION NO. 22861 DATE 12-20-95 TAX MAP NO. 8M-9-A-4 Watershed: ☐ Yes ☒ No

OWNER OR CONTRACTOR SUN-WOOD BUILDING PHONE: Business Home 872-0922

ADDRESS P.O. BOX 5877 STATESVILLE, NC 28677

LOCATION I-40 W, TR OLD MTN. RD, TR CONIFER DR, TL PINE BARK COURT, LOT ON RIGHT AT CUL-DE-SAC

SUBDIVISION PINE RIDGE BLOCK / SECTION LOT 4 LOT AREA 0.680 AC SITE CLASS PS DESIGN FLOW 360 L.T.A.R. 0.3 GPD/FT²

Septic Tank: 1000 Gallons; STB 1012 Date 9/22/95

Pump Tank: Gallons; PT Date

Pump Make: Model Serial No.

Nitrification Field: No Fields 1 Square Feet 1200 Linear Feet 300

No Lines 4 Trench Width 36" Max Trench Bottom Depth 24"-36" Gravel Depth N/A

☒ New System ☐ Repair System Type: I, II, III, IV, V, VI

System Description: CHAMBERED GRAVITY

Repair System Description: CHAMBERED GRAVITY

Maintenance Agreement Required: ☐ Yes ☒ No

☐ House/Mod. Home No. Bedrooms 3

☒ Mobile Home No. Bathrooms 2

☐ Business No. Employees

☐ Other


☐ Slab ☒ Crawl Space ☐ Basement w/plumbing ☐ Basement wo/plumbing

Water Supply: ☐ Individual ☐ Community ☒ Public


Comments: ① INSTALL 50 CHAMBERS ON CONTOUR IN FOUR LINES AS SHOWN ② USE THREE FLOW DIVIDERS TO ACHIEVE EQUAL DISTRIBUTION INTO EACH OF FOUR LINES ③ KEEP SYSTEM MINIMUM 10' FROM PROPERTY LINE, 5' FROM MH

Comments: Upper two lines have 13 chambers compared to 12 as initial site sketch. Lower two lines have 12 chambers compared to 13 as initial site sketch.

INITIAL SITE SKETCH

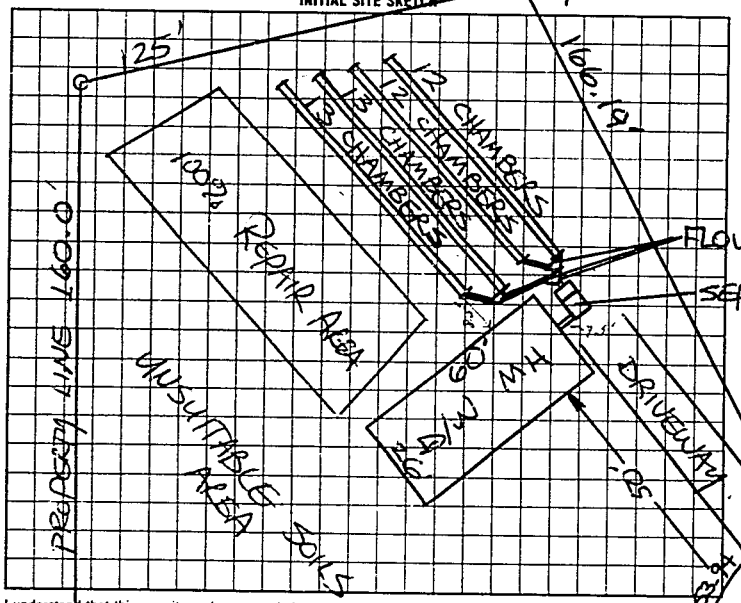

AS BUILT SKETCH

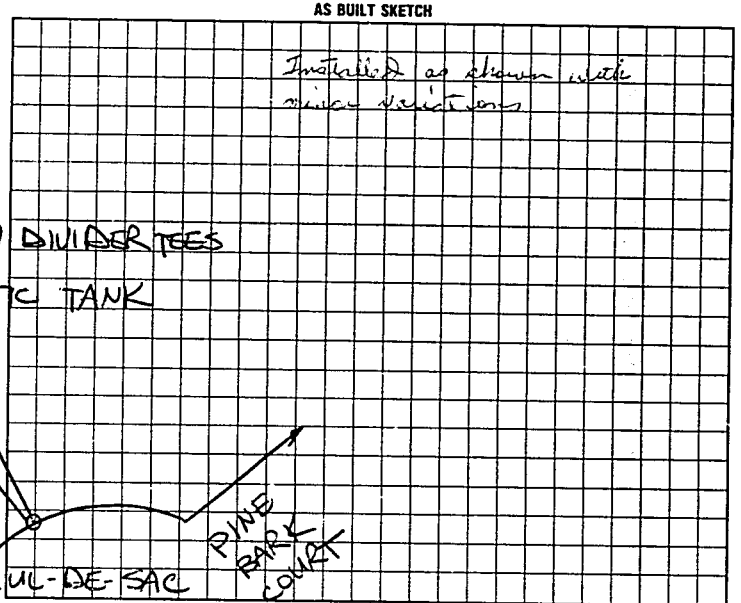

I understand that this permit can be suspended or revoked if any false information is supplied toward securing the permit/any unauthorized changes are made to the site/any unauthorized changes are made in the installation of the system.

AUTHORIZATION TO CONSTRUCT IS VALID FIVE (5) YEARS FROM DATE OF ISSUANCE. IMPROVEMENT PERMIT HAS NO EXPIRATION DATE

Signed: Jerry W Parker 173.32

Improvement Permit by: STEVE HENDRICK date 12-20-95

AUTHORIZATION TO CONSTRUCT

~~Existing System Inspection~~ by: STEVE HENDRICK date 12-20-95

Installed by: Tommy Cothren

~~Certificate of Completion by~~ date

Operation Permit by date 2/15/96

HEALTH DEPT COPY WHITE | INSPECTION COPY (FINAL) GREEN | OWNER COPY (FINAL) YELLOW | INSPECTION COPY (INITIAL) PINK | OWNER COPY (INITIAL) GOLD

15200