IREDELL COUNTY HEALTH DEPARTMENT

STATESVILLE 704-878-5305 MOORESVILLE 704-664-5281

IMPROVEMENT PERMIT / AUTHORIZATION TO CONSTRUCT / OPERATION PERMIT / EXISTING SYSTEM INSPECTION

PERMIT# 92489 PIN# 4704 81 0004 DATE 10/24/00

OWNER OR CONTRACTOR Randy C. Brown PHONE: Business _____ Home 872-6094

ADDRESS 724 Baker St Statesville NC 28677

LOCATION Old Mtn. R Beulah, on RT

SUBDIVISION _____ BLOCK / SECTION _____ LOT _____ LOT AREA 0.90 AC SITE CLASS PS DESIGN FLOW 360 L.T.A.R. 0.5

Septic Tank: 1000 Gallons: STB 1007 Date 9-23-00
Pump Tank: _____ Gallons: PT _____ Date _____
Pump Make: _____ Model _____ Serial No _____
Nitrification Field: No Fields 1 Square Feet 1200 Linear Feet 400
No Lines 6 @ 67' Trench Width 36" Max Trench Bottom Depth 36"

☒ New System ☐ Repair System Type: I. II. III. IV. V. VI
System Description: Gravity Conv.
Repair System Description: Same
Maintenance Agreement Required: ☐ Yes ☒ No
Gravel Depth 12" ☐ Slab ☒ Crawl Space ☐ Basement w/plumbing ☐ Basement wo/plumbing


☐ House/Mod. Home No. Bedrooms 3
☒ Mobile Home No. Bathrooms 2
☐ Business No. Employees _____
☐ Other _____

Water Supply: ☐ Individual ☒ Public ☐ Community


Comments:/Conditions:

Comments:/Conditions: poly lok Filter Installed
- Septic Tank Marker + Risers Installed

INITIAL SITE SKETCH

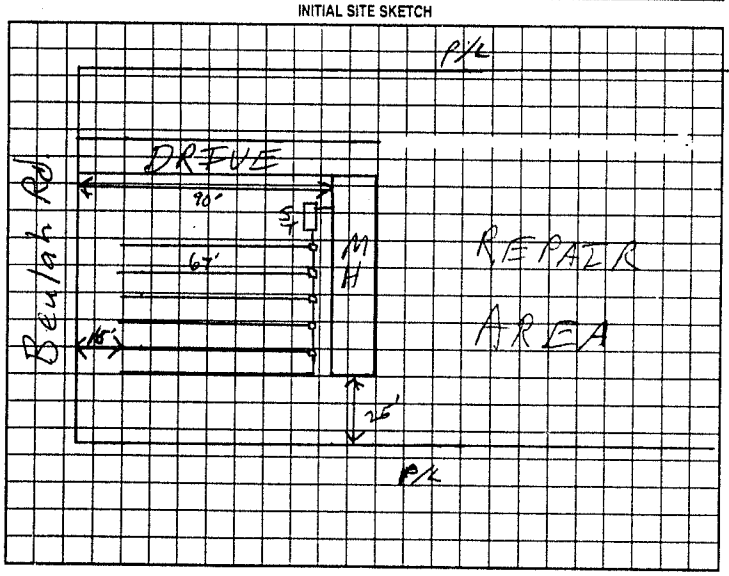

AS BUILT SKETCH

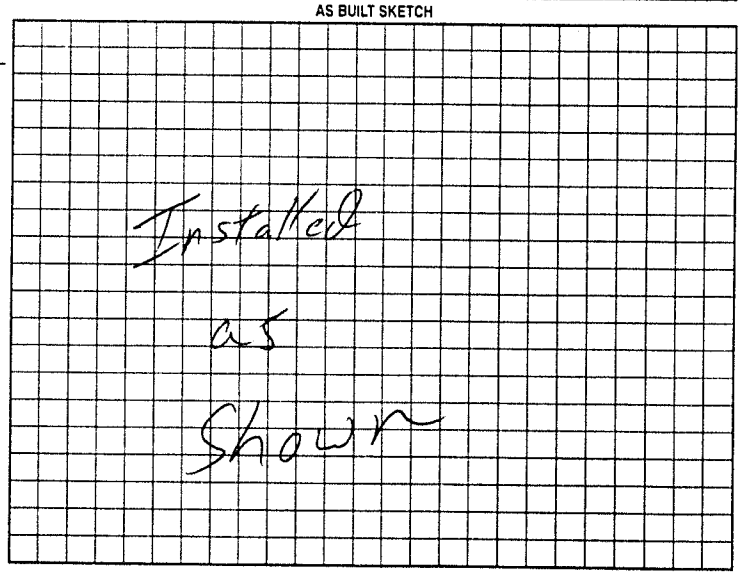

Permit can be suspended or revoked if any false information is supplied toward securing the permit/any unauthorized changes are made to the site/any unauthorized changes are made in the installation of the system. Improvement Permit with plat valid without expiration. Improvement Permit with site plan valid for sixty months. Authorization to Construct is valid for a period equal to that of Improvement Permit – not to exceed sixty months.

Signed: R Brown date 10-26-00 Installed by: Travis Enterprises Inc.

Improvement Permit by: RST date 10/24/00 Operation Permit by: William C. Johnson date 2/27/01

Authorization to Construct by: RST date 10/24/00 Existing System Inspection by: _____ date _____

HEALTH DEPT. COPY: WHITE OWNER COPY (FINAL): YELLOW OWNER COPY (INITIAL) PINK