IREDELL COUNTY HEALTH DEPARTMENT

STATESVILLE 704-878-5305 MOORESVILLE 704-664-5281

IMPROVEMENT PERMIT / AUTHORIZATION TO CONSTRUCT / OPERATION PERMIT / EXISTING SYSTEM INSPECTION

PERMIT# 093204 PIN# 4704 73 4898 (PT) DATE 12-11-00

OWNER OR CONTRACTOR BEE YANG PHONE: Business Home 878-9540

ADDRESS 212 CHAMBER ST, STATESVILLE NC 28677

LOCATION I-40 W, TR OLD MTN. RD, TR LARUE CIRCLE, 1ST STREET TO LEFT 1ST MH ON LEFT

SUBDIVISION YANG BLOCK / SECTION LOT 1 LOT AREA 10.5 ACRES SITE CLASS PS DESIGN FLOW 480 L.T.A.R. 0.20 GPD/FT²

Septic Tank: 1000 Gallons: STB 1012 Date 9-25-2000
Pump Tank: Gallons: PT Date
Pump Make: Model Serial No
Nitrification Field: No Fields 1 Square Feet EQ TO 2400 Linear Feet 600+
No Lines TEN Trench Width 36" Max Trench Bottom Depth 30"


☑ New System ☐ Repair System Type: I, II, III, IV, V, VI
System Description: 25% REDUCTION GRAVITY
Repair System Description: 25% REDUCTION PUMP
Maintenance Agreement Required: ☐ Yes ☑ No
Gravel Depth SAND 6" ☐ Slab ☑ Crawl Space ☐ Basement w/plumbing ☐ Basement wo/plumbing

☐ House/Mod. Home ☑ Mobile Home ☐ Business ☐ Other
No. Bedrooms 4 No. Bathrooms 2 No. Employees

Water Supply: ☑ Individual ☐ Public ☐ Community
WELL

Comments/Conditions: ① INSTALL SUBSURFACE INTERCEPT DRAINAGE DITCH AS SHOWN BEGINNING 42" DEEP TO DAYLIGHT ② INSTALL 100 CHAMBERS OR 60 HDS SECTIONS ON CONTOUR


INITIAL SITE SKETCH

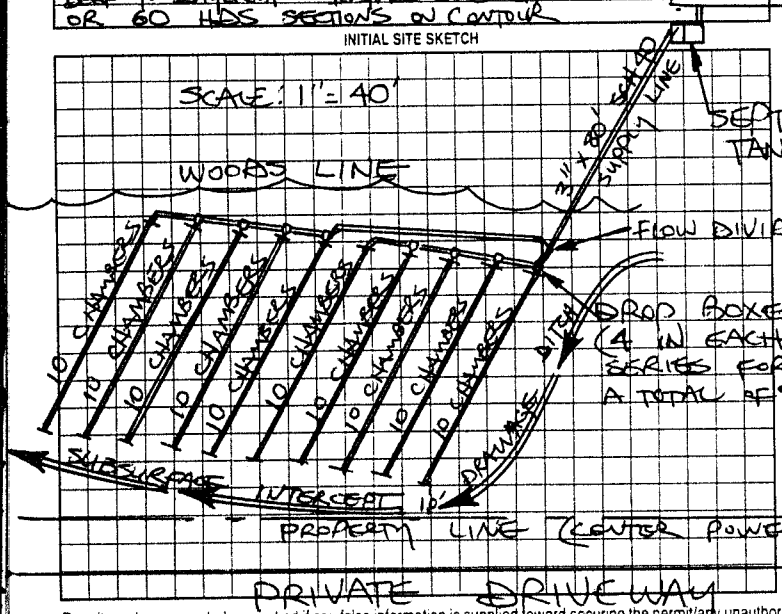

PROPOSED D/W MH 72'

Comments/Conditions: ③ KEEP SYSTEM MINIMUM 100 FEET FROM WELL (- Poly Lock Fitter Installed - Risers Installed)

AS BUILT SKETCH

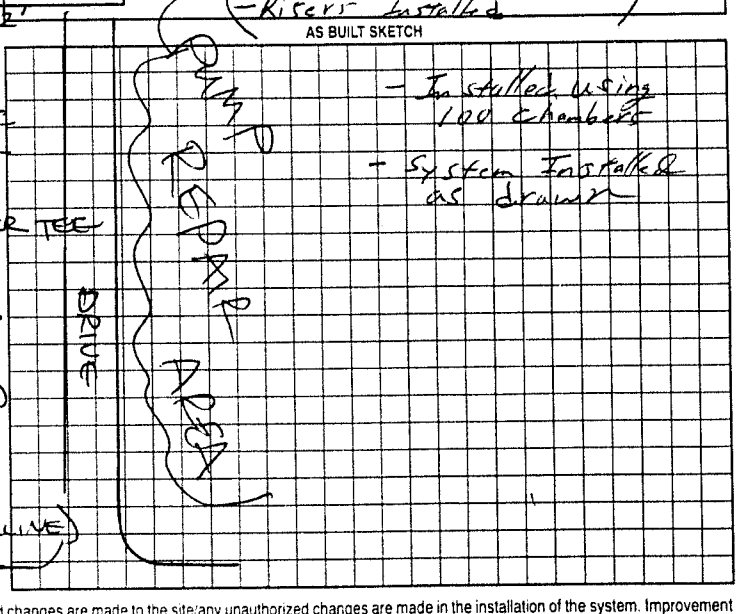

Permit can be suspended or revoked if any false information is supplied toward securing the permit/any unauthorized changes are made to the site/any unauthorized changes are made in the installation of the system. Improvement Permit with plat valid without expiration. Improvement Permit with site plan valid for sixty months. Authorization to Construct is valid for a period equal to that of Improvement Permit – not to exceed sixty months.

Signed: Bee Yang date 12/11/00 Installed by: Steve Jordan

Improvement Permit by: STEVE HEDRICK date 12-11-00 Operation Permit by: William C. Johnson REHS date 1/10/01

Authorization to Construct by: STEVE HEDRICK date 12-11-00 Existing System Inspection by: date

HEALTH DEPT. COPY WHITE OWNER COPY (FINAL) YELLOW OWNER COPY (INITIAL) PINK