IREDELL COUNTY HEALTH DEPARTMENT

STATESVILLE 704-878-5305 MOORESVILLE 704-664-5281

IMPROVEMENT PERMIT / AUTHORIZATION TO CONSTRUCT / OPERATION PERMIT / EXISTING SYSTEM INSPECTION

PERMIT# 092653 PIN# 4704 73 4691 (PT) DATE 11-6-00

OWNER OR CONTRACTOR PROCTOR YANG PHONE: Business Home 871-8970

ADDRESS 135 YANG DRIVE, STATESVILLE, NC 28625

LOCATION I-40 W, TR OLD MTN. ROAD, TR LARUE, CIRCLE, TL NEW "UNNAMED" ST, 3RD LOT ON RIGHT

SUBDIVISION YANG SUB BLOCK / SECTION LOT 3 LOT AREA 15.8 ACRES SITE CLASS PS DESIGN FLOW 480 L.T.A.R. 0.40 GPD/FT2

Septic Tank: 1000 Gallons: STB 1012 Date 9/11/00
Pump Tank: Gallons; PT Date
Pump Make: Model Serial No.
Nitrification Field: No Fields 1 Square Feet 1200 Linear Feet 400
No Lines FOUR Trench Width 36" Max Trench Bottom Depth 36" Gravel Depth 12"

✓ New System ☐ Repair System Type: (I) II, IV, V, VI
System Description: CONVENTIONAL GRAVITY
Repair System Description: 25% REDUCTION REQ
Maintenance Agreement Required: ☐ Yes ☑ No

☐ House/Mod. Home ☑ Mobile Home ☐ Business ☐ Other
No. Bedrooms 4 No. Bathrooms 2 No. Employees

Water Supply: ☑ Individual ☐ Public ☐ Community
WELL


☐ Slab ☑ Crawl Space ☐ Basement w/plumbing ☐ Basement wo/plumbing

Comments/Conditions:

Comments/Conditions Poly-Lok Filter installed

SCALE: 1" = 40'

INITIAL SITE SKETCH

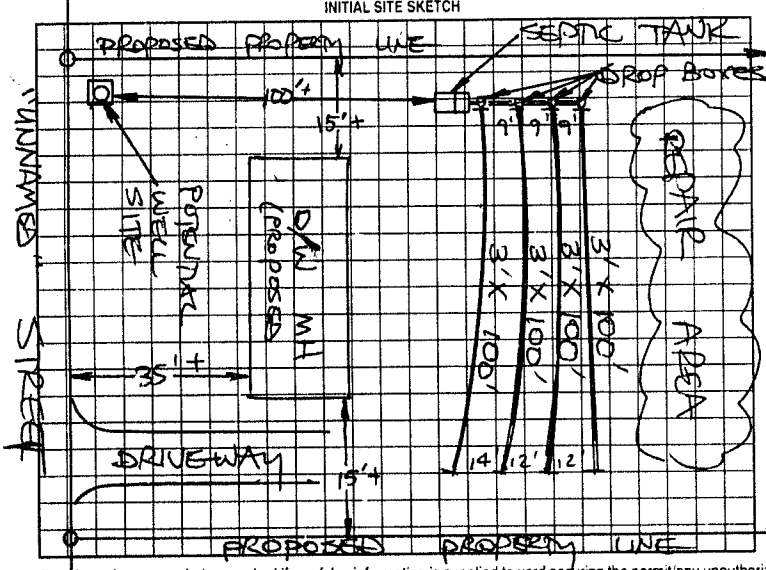

AS BUILT SKETCH

Installed as Drawn

Permit can be suspended or revoked if any false information is supplied toward securing the permit/any unauthorized changes are made to the site/any unauthorized changes are made in the installation of the system. Improvement Permit with plat valid without expiration. Improvement Permit with site plan valid for sixty months. Authorization to Construct is valid for a period equal to that of Improvement Permit – not to exceed sixty months.

Signed: x Proctor Yang date 11-6-00 Installed by: A-1 Backhoe

Improvement Permit by: STEVE HEDRICK date 11-6-00 Operation Permit by: RSI date 12/11/00

Authorization to Construct by: STEVE HEDRICK date 11-6-00 Existing System Inspection by: date

HEALTH DEPT. COPY: WHITE OWNER COPY (FINAL) YELLOW OWNER COPY (INITIAL) PINK