IREDELL COUNTY HEALTH DEPARTMENT

STATESVILLE 704-878-5305 MOORESVILLE 704-664-5281

IMPROVEMENT PERMIT / AUTHORIZATION TO CONSTRUCT / OPERATION PERMIT / EXISTING SYSTEM INSPECTION

PERMIT# 09913 PIN# 4709 93 03666 (PART) DATE 2-21-01

OWNER OR CONTRACTOR LONG CHING YANG PHONE: Business Home

ADDRESS 155 YANG DRIVE, STATESVILLE NC 28625

LOCATION I-40 W, TR OLD MTN. RD, TR LARUE CIRCLE, TL BROTHERS LANE, 1ST LOT ON RIGHT

SUBDIVISION BLOCK / SECTION LOT LOT AREA 4.28 ACRES SITE CLASS PS DESIGN FLOW 480 L.T.A.R. 0.30 SPD / FT2

Septic Tank: 1000 Gallons; STB 786 Date 2-29-01
Pump Tank: Gallons; PT Date
Pump Make: Model Serial No.
Nitrification Field: No Fields 1 Square Feet 1600 Linear Feet 533
No Lines FIVE Trench Width 36" Max Trench Bottom Depth 36" Gravel Depth 12"

☑ New System ☐ Repair System Type: I (II) III, IV, V, VI
System Description: CONVENTIONAL GRAVITY
Repair System Description: CONV. GRAVITY
Maintenance Agreement Required: ☐ Yes ☑ No
☐ Slab ☑ Crawl Space ☐ Basement w/plumbing ☐ Basement wo/plumbing


☐ House/Mod. Home No. Bedrooms 4
☑ Mobile Home No. Bathrooms 2
☐ Business No. Employees
☐ Other

Water Supply: ☑ Individual ☐ Public ☐ Community
WELL


Comments/Conditions: KEEP SYSTEM MAXIMUM FEASIBLE DISTANCE FROM WELL (75'+) NOT LESS THAN 50'

Comments/Conditions: - Sytic Tank marks installed
- Poly lok filter installed

INITIAL SITE SKETCH

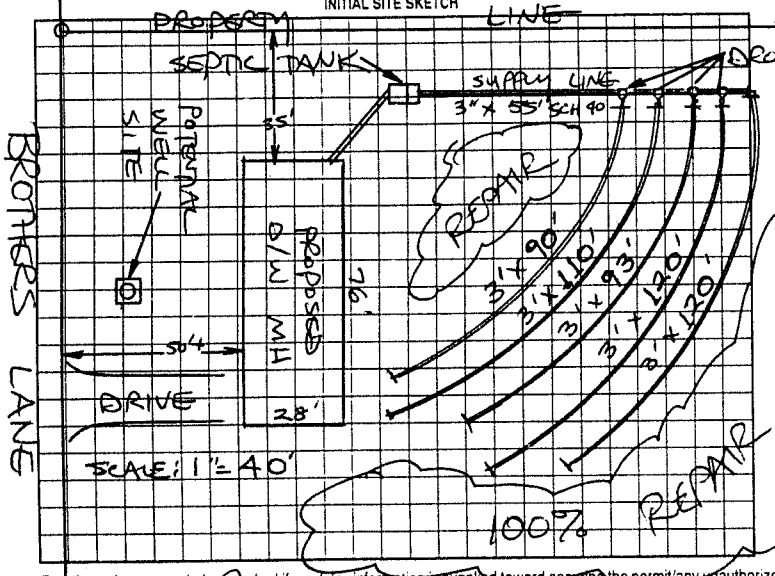

AS BUILT SKETCH

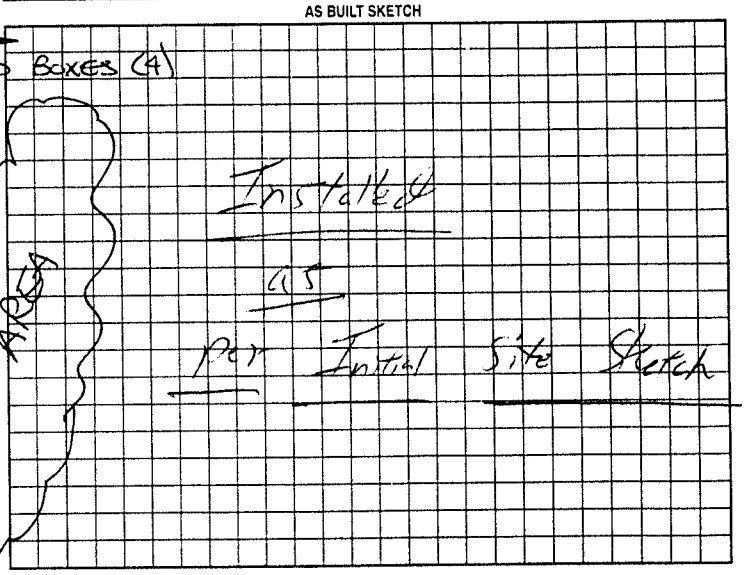

Permit can be suspended or revoked if any false information is supplied toward securing the permit/any unauthorized changes are made to the site/any unauthorized changes are made in the installation of the system. Improvement Permit with plat valid without expiration. Improvement Permit with site plan valid for sixty months. Authorization to Construct is valid for a period equal to that of Improvement Permit – not to exceed sixty months.

Signed: X [signature] date 2/21/01 Installed by: Rapupp's Grading Inc

Improvement Permit by: STEVE HEDRICK date 2-21-01 Operation Permit by: [signature] RSI date 4/18/01

Authorization to Construct by: STEVE HEDRICK date 2-21-01 Existing System Inspection by: date

HEALTH DEPT. COPY: WHITE OWNER COPY (FINAL): YELLOW OWNER COPY (INITIAL): PINK