22413

IREDELL COUNTY HEALTH DEPARTMENT

STATESVILLE 704-878-5305 MOORESVILLE 704-664-5281

IMPROVEMENT PERMIT / CERTIFICATE OF COMPLETION / OPERATION PERMIT / EXISTING SYSTEM INSPECTION

PROPERTY DESCRIPTION NO. 22473 DATE 10-17-96 TAX MAP NO. 8M-9-A-20 Watershed: ☐ Yes ☑ No

OWNER OR CONTRACTOR Ernest H. Runge PHONE: Business _____ Home 872 6645

ADDRESS 374 Long Island Rd 226

LOCATION I-40 W TR on Rt mtn Rd TR Conifer Dr. 7th lot on Rt past Pine Bark Ct.

SUBDIVISION Pine Ridge BLOCK / SECTION _____ LOT 20 LOT AREA .1717 acres SITE CLASS. PS DESIGN FLOW 360 L.T.A.R. .13

Septic Tank: 1000 Gallons: STB 1012 Date 7-13-96

Pump Tank: _____ Gallons: PT _____ Date _____

Pump Make: _____ Model _____ Serial No _____

Nitrification Field: No Fields 1 Square Feet 1200 Linear Feet 400

No Lines 3 Trench Width 36" Max Trench Bottom Depth 36" Gravel Depth 12"

☑ New System ☐ Repair System Type: I ☑ II, III, IV, V, VI

System Description: Conv. Gravity

Repair System Description: " "

Maintenance Agreement Required: ☐ Yes ☑ No

☐ Slab ☑ Crawl Space ☐ Basement w/plumbing ☐ Basement wo/plumbing

☐ House/Mod. Home No. Bedrooms 3

☐ Mobile Home No. Bathrooms 2

☐ Business No. Employees _____


☐ Other _____

Water Supply: ☐ Individual ☐ Community ☑ Public


Comments: Replaces permit issued 11-16-95

Comments: Lines were installed off Grade To start Had To use Step towns & regrade Ditch To Correct

INITIAL SITE SKETCH

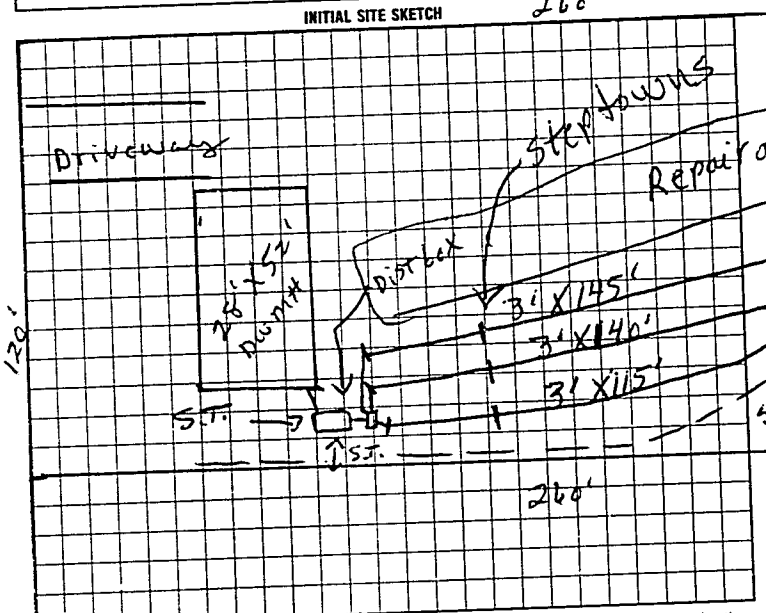

AS BUILT SKETCH

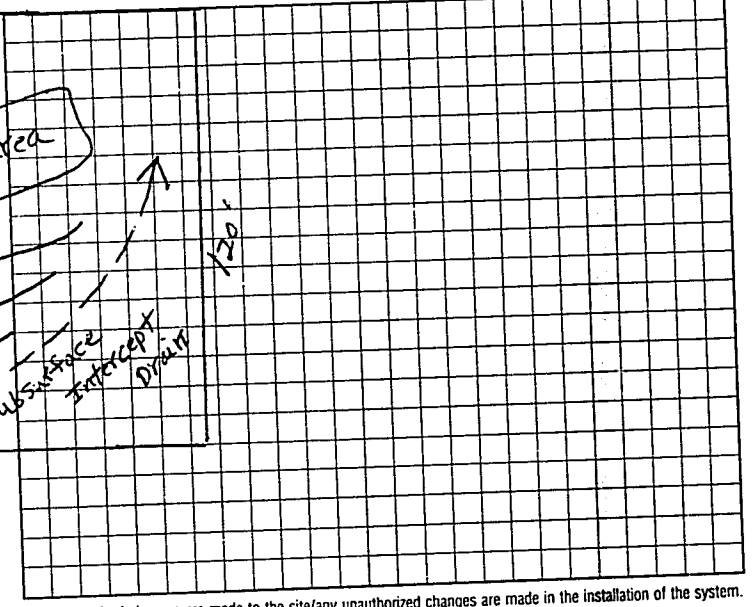

I understand that this permit can be suspended or revoked if any false information is supplied toward securing the permit/any unauthorized changes are made to the site/any unauthorized changes are made in the installation of the system.

Signed: _____ Installed by: Rick Shook

Improvement Permit by: P. C. Moore date 10-17-96 Certificate of Completion by: P. C. Moore date 11-6-96

Existing System Inspection by: P. C. Moore date 10-17-96 Operation Permit by: _____ date _____

Authorization to cover

Authorization to count. EXPIRES 2 years from issue

HEALTH DEPT. COPY: WHITE INSPECTION COPY (FINAL): GREEN OWNER COPY (FINAL): YELLOW INSPECTION COPY (INITIAL): PINK OWNER COPY (INITIAL): GOLD

0 0 2 0 3 7