IREDELL COUNTY HEALTH DEPARTMENT

STATESVILLE 704-878-5305 MOORESVILLE 704-664-5281

#63770

IMPROVEMENT PERMIT / CERTIFICATE OF COMPLETION / OPERATION PERMIT / EXISTING SYSTEM INSPECTION

PROPERTY DESCRIPTION NO. 23071 DATE 2-5-96 TAX MAP NO. 8M-9-A-6 Watershed: Yes ✓No

OWNER OR CONTRACTOR ERNEST H. RUNSE PHONE: Business Home 872-6645

ADDRESS 374 LONG ISLAND ROAD 169 STATESVILLE, NC 28677

LOCATION I-40 W, TR OLD MTN RD, TR CONIFER DRIVE, 2ND LOT ON LEFT PAST PINEBARK COURT

SUBDIVISION PINE RIDGE EST. BLOCK / SECTION LOT 6 LOT AREA 0.823 SITE CLASS PS DESIGN FLOW 360 L.T.A.R. 0.3 GPD/FT²

Septic Tank 1000 Gallons; STB 794 Date 8-6-96
Pump Tank Gallons; PT Date
Pump Make Model Serial No
Nitrification Field No Fields 1 Square Feet 1200 Linear Feet 400
No Lines 4 Trench Width 36" Max Trench Bottom Depth 18-36" Gravel Depth 12"

✓New System Repair System Type (I) II III IV V
System Description: CONVENTIONAL GRAVITY
Repair System Description: CONV. GRAVITY
Maintenance Agreement Required Yes ✓No
Slab ✓Crawl Space Basement w/plumbing Basement wo/plumbing


House/Mod Home No. Bedrooms 3
Mobile Home No Bathrooms 2
Business No Employees
Other

Water Supply
☐ Individual
☐ Community
✓Public

Comments ① USE THREE FLOW DIVIDER TEES TO ACHIEVE EQUAL DISTRIBUTION INTO EACH OF FOUR LINES ② REAR OF LOT TO BE RESERVED FOR SEPTIC SYSTEM SERVING LOT #5.

Comments House not on site time of inspec.

INITIAL SITE SKETCH

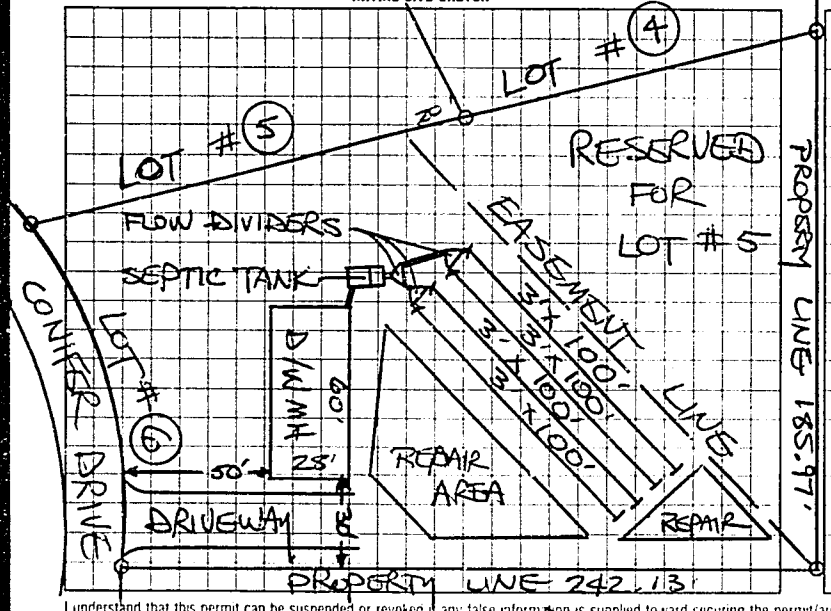

AS BUILT SKETCH

Installed as shown

I understand that this permit can be suspended or revoked if any false information is supplied toward securing the permit/any unauthorized changes are made to the site/any unauthorized changes are made in the installation of the system.

AUTHORIZATION TO CONSTRUCT IS VALID FIVE (5) YEARS FROM DATE OF ISSUANCE. IMPROVEMENT PERMIT HAS NO EXPIRATION DATE.

Signed

Installed by A-1 Backhoe

Improvement Permit by STEVE HEDRICK date 2-5-96

~~Certificate of Completion by~~ date

AUTHORIZATION TO CONSTRUCT

Existing System Inspection by STEVE HEDRICK date 4-10-96

Operation Permit by Mark CO of PS date 10-15-96

HEALTH DEPT COPY WHITE | INSPECTION COPY (FINAL) GREEN | OWNER COPY (FINAL) YELLOW | INSPECTION COPY (INITIAL) PINK | OWNER COPY (INITIAL) GOLD

0020026