IREDELL COUNTY HEALTH DEPARTMENT

STATESVILLE 704-878-5305 (Fax) MOORESVILLE 704-664-5281

IMPROVEMENT PERMIT / CERTIFICATE OF COMPLETION / OPERATION PERMIT / EXISTING SYSTEM INSPECTION

PROPERTY DESCRIPTION NO. 2H1.93 DATE 8-19-96 TAX MAP NO. 8nn-9-A-25 Watershed: ☐ Yes ☒ No

OWNER OR CONTRACTOR Expert H. Quinn PHONE: Business Home 872 6645

ADDRESS 3174 Island Ford Rd Statesville

LOCATION I-40 W TR Elnath TR Conifer 1/8 mi Rt

SUBDIVISION Pine Silver BLOCK / SECTION LOT 25 LOT AREA 120' X 254' SITE CLASS. 05 DESIGN FLOW 360 L.T.A.R. .3

Septic Tank: 1000 Gallons; STB 501 Date 10-6-94

Pump Tank: Gallons; PT Date

Pump Make: Model Serial No.

Nitrification Field: No Fields 1 Square Feet 1200 Linear Feet 400

No Lines 4 Trench Width 24" Max Trench Bottom Depth 34" Gravel Depth 12"

☐ New System ☐ Repair System Type: I, II, III, IV, V, VI

System Description: Conv. Gravity

Repair System Description:

Maintenance Agreement Required: ☐ Yes ☒ No

☐ House/Mod. Home No. Bedrooms 3

☐ Mobile Home No. Bathrooms 2

☐ Business No. Employees

☐ Other


☐ Slab ☒ Crawl Space ☐ Basement w/plumbing ☐ Basement wo/plumbing

Water Supply: ☐ Individual ☐ Community ☒ Public


Comments:

Comments:

INITIAL SITE SKETCH

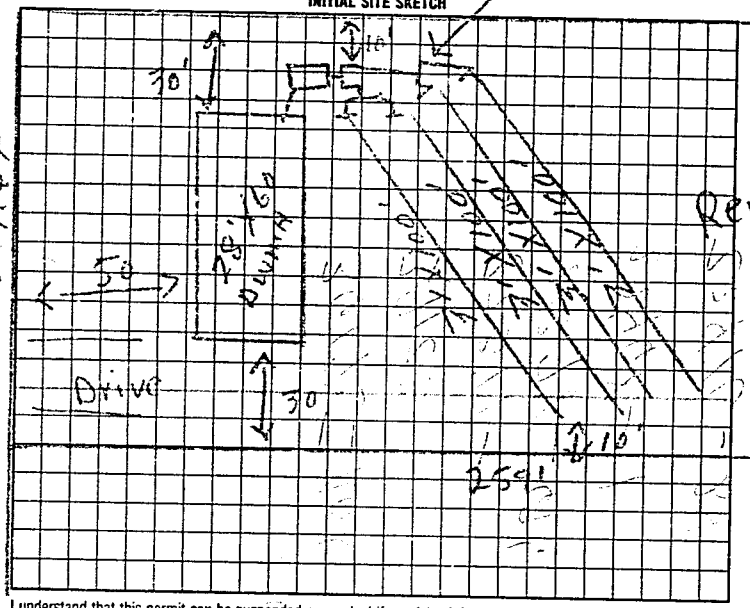

AS BUILT SKETCH

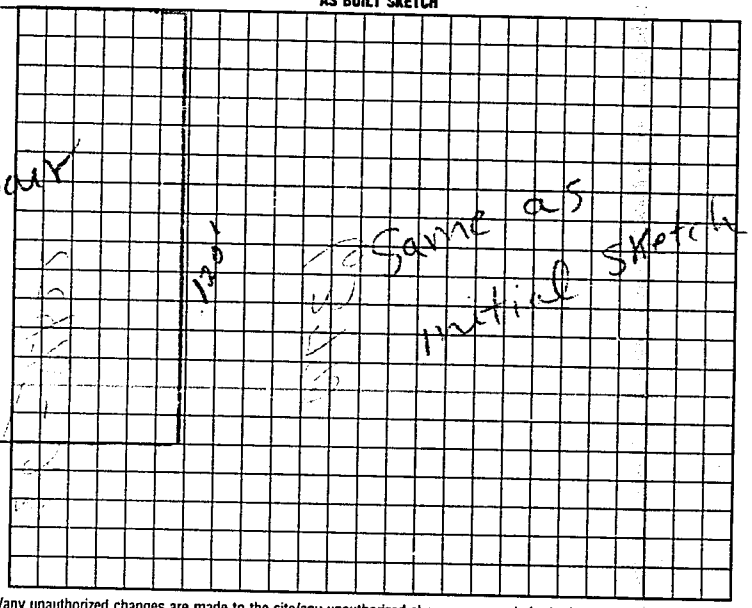

I understand that this permit can be suspended or revoked if any false information is supplied toward securing the permit/any unauthorized changes are made to the site/any unauthorized changes are made in the installation of the system.

Signed:

Improvement Permit by: D.C. Moore date 8-19-96

Existing System Inspection by: D.C. Moore date 8-19-96

Installed by: G & M Enterprises

Certificate of Completion by: date

Operation Permit by: D.C. Moore date 11-7-96

Authorization Expires 60 days from issue

HEALTH DEPT. COPY: WHITE INSPECTION COPY (FINAL): GREEN OWNER COPY (FINAL): YELLOW INSPECTION COPY (INITIAL): PINK OWNER COPY (INITIAL): GOLD

E 0 2 0 0 7 3