IREDELL COUNTY HEALTH DEPARTMENT

STATESVILLE 704-878-5305 MOORESVILLE 704-664-5281

22475

IMPROVEMENT PERMIT / CERTIFICATE OF COMPLETION / OPERATION PERMIT / EXISTING SYSTEM INSPECTION

PROPERTY DESCRIPTION NO. 22475 DATE 11-20-95 TAX MAP NO 8M-9-A-23 Watershed: ☐ Yes ☑ No

OWNER OR CONTRACTOR ERNEST H. RUNGE PHONE: Business Home 872-6695

ADDRESS 374 LONG ISLAND ROAD STATESVILLE NC 28677

LOCATION I-40 W TR OLD MOUNTAIN ROAD, TR CONIFER DR, 4TH LOT ON RIGHT

SUBDIVISION PINE RIDGE EST BLOCK / SECTION LOT 23 LOT AREA 0.715 ACRE SITE CLASS. PD DESIGN FLOW 360 L.T.A.R. 0.25 GPD/FT²

Septic Tank: 1000 Gallons; STB 794 Date 3-25-96

Pump Tank: Gallons; PT Date

Pump Make: Model Serial No.

Nitrification Field: No Fields 1 Square Feet 1440 Linear Feet 3600

No Lines 4 Trench Width 36" Max Trench Bottom Depth 24-36" Gravel Depth N/A

☑ New System ☐ Repair System Type: I, II, III, IV, V, VI

System Description: CHAMBERED GRAVITY-FED

Repair System Description: CHAMBERED, GRAVITY-FED

Maintenance Agreement Required: ☐ Yes ☑ No

☐ House/Mod. Home ☑ Mobile Home ☐ Business ☐ Other

No. Bedrooms 3 No. Bathrooms 2 No. Employees


☐ Slab ☑ Crawl Space ☐ Basement w/plumbing ☐ Basement wo/plumbing

Water Supply: ☐ Individual ☐ Community ☑ Public

Comments: ① INSTALL GC CHAMBERS IN FOUR LINES AS SHOWN, ② USE TYPE FLOW DIVIDER TEES TO ACHIEVE EQUAL DISTRIBUTION INTO EACH OF FOUR LINES ③ INSTALL SURFACE DIVERSION DITCH AT LOCATION SHOWN

Comments:

INITIAL SITE SKETCH

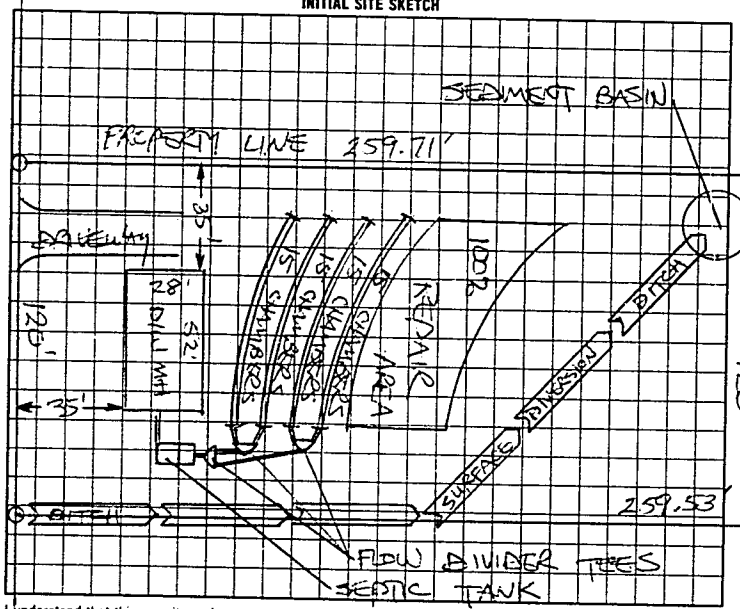

AS BUILT SKETCH

SYSTEM INSTALLED ACCORDING TO INITIAL SITE SKETCH

I understand that this permit can be suspended or revoked if any false information is supplied toward securing the permit/any unauthorized changes are made to the site/any unauthorized changes are made in the installation of the system. AUTHORIZATION TO CONSTRUCT IS VALID FIVE (5) YEARS FROM DATE OF ISSUANCE. IMPROVEMENT PERMIT HAS NO EXPIRATION DATE.

Signed

Improvement Permit by: STEVE HEDRICK date 11-20-95

~~Authorization to Construct~~ ~~Existing System Inspection~~ by: STEVE HEDRICK date 4-10-96

Installed by: A-1 BACKHOE

~~Certificate of Completion by:~~ date

Operation Permit by: STEVE HEDRICK date 6-24-96

HEALTH DEPT. COPY: WHITE INSPECTION COPY (FINAL) GREEN OWNER COPY (FINAL) YELLOW INSPECTION COPY (INITIAL) PINK OWNER COPY (INITIAL) GOLD