Walter Bartimacus

IREDELL COUNTY HEALTH DEPARTMENT

STATESVILLE 704-878-5305 MOORESVILLE 704-664-5281

62067

IMPROVEMENT PERMIT / CERTIFICATE OF COMPLETION / OPERATION PERMIT / EXISTING SYSTEM INSPECTION

PROPERTY DESCRIPTION NO 23070 DATE 2-7-96 TAX MAP NO 8M-9-A-8 Watershed Yes No

OWNER OR CONTRACTOR ERNEST H. RUNGE PHONE Business Home 872-6645

ADDRESS 374 LON 6 ISLAND ROAD STATESVILLE, NC 28677

LOCATION I-40 W TR OLD MTN. RD, TR CONIFER DRIVE, 4TH LOT ON LEFT PAST PINE BARK COURT

SUBDIVISION PINE RIDGE BLOCK / SECTION ____ LOT 8 LOT AREA 1.309 Ac SITE CLASS PS DESIGN FLOW 360 LTAR 0.3 GPD/FT²

Septic Tank 1000 Gallons STB 1012 Date 4-21-96
Pump Tank ____ Gallons PT ____ Date ____
Pump Make ____ Model ____ Serial No ____
Nitrification Field No Fields I Square Feet 1200 Linear Feet 400
No Lines 4 Trench Width 36" Max Trench Bottom Depth 18-36" Gravel Depth 12"

New System Repair System Type (I II A V)
System Description CONVENTIONAL GRAVITY
Repair System Description CONV. GRAVITY
Maintenance Agreement Required Yes No


House/Mod Home No Bedrooms 3
Mobile Home No Bathrooms 2
Business No Employees ____
Other ____
Slab Crawl Space Basement w/plumbing Basement wo/plumbing

Water Supply: Individual Community Public

Comments: USE THREE FLOW DIVIDER TEES TO ACHIEVE EQUAL DISTRIBUTION INTO EACH OF FOUR 100' LINES.

Comments: DISTRIBUTION BOX SUBSTITUTED FOR FLOW DIVIDER TEES DUE TO SHALLOW DEPTH OF DRAINFIELD

INITIAL SITE SKETCH

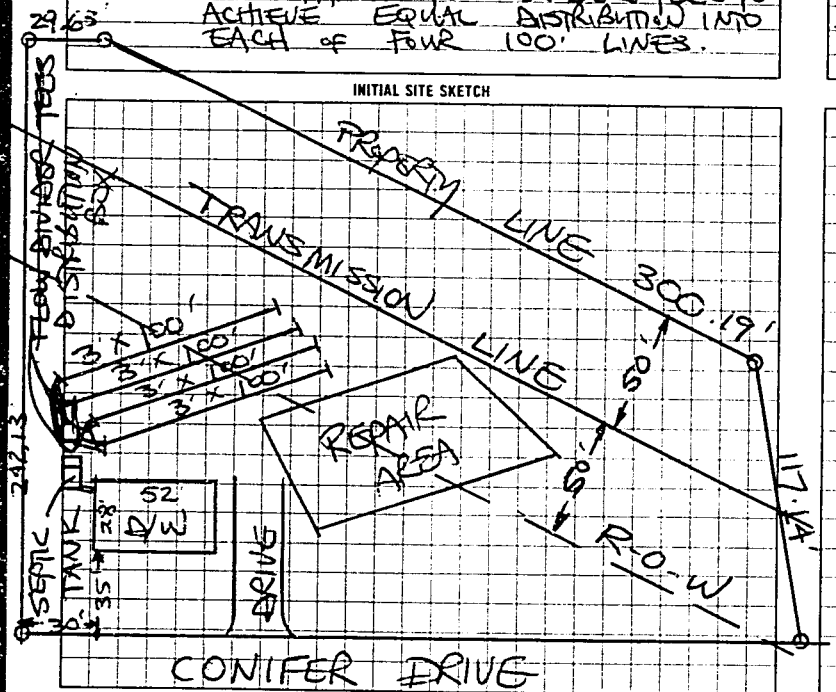

AS BUILT SKETCH

SYSTEM INSTALLED ACCORDING TO INITIAL SITE SKETCH

I understand that this permit can be suspended or revoked if any false information is supplied herein or concerning the permit, any unauthorized changes are made to the site, any unauthorized changes are made in the installation of the system

AUTHORIZATION TO CONSTRUCT IS VALID FIVE (5) YEARS FROM DATE OF ISSUANCE. IMPROVEMENT PERMIT HAS NO EXPIRATION DATE

Signed ____ Installed by FORREST STAFFORD

Improvement Permit by STEVE HEDRICK date 2-7-96 ~~Certificate of Completion~~ by ____ date ____

AUTHORIZATION TO CONSTRUCT Existing System Inspection by STEVE HEDRICK date 2-7-96 Operation Permit by STEVE HEDRICK date 7-8-96

HEALTH DEPT COPY (WHITE) INSPECTION COPY (PINK) GREEN OWNER COPY (PINK) YELLOW INSPECTION COPY (INITIAL) PINK OWNER COPY (INITIAL) GOLD

L 0 2 0 0