David Bates 22715

IREDELL COUNTY HEALTH DEPARTMENT

STATESVILLE 704-878-5305 MOORESVILLE 704-664-5281

IMPROVEMENT PERMIT / CERTIFICATE OF COMPLETION / OPERATION PERMIT / EXISTING SYSTEM INSPECTION

PROPERTY DESCRIPTION NO. 22715 DATE 6-17-96 TAX MAP NO. 8m-9-A-9

OWNER OR CONTRACTOR Ernest Runge PHONE: Business Home 872 6645

ADDRESS 374 Long Island Rd Statesville Watershed: ☐ Yes ☐ No

LOCATION I-40 W to TR 01 mtn TR Conifer Dr 1/2mi left

SUBDIVISION Pine Ridge Est BLOCK / SECTION LOT 9 LOT AREA 1.323 acres SITE CLASS PS DESIGN FLOW 360 L.T.A.R. .25

Septic Tank: 1000 Gallons; STB 821 Date 10-5-96

Pump Tank: Gallons; PT Date

Pump Make: Model Serial No.

Nitrification Field: No Fields 1 Square Feet 1440 Linear Feet 480

No Lines 6 Trench Width 36" Max Trench Bottom Depth 36" Gravel Depth 12"

☒ New System ☐ Repair System Type: I, II, III, IV, V, VI

System Description: Conv. Gravity

Repair System Description: Pump to Chambers

Maintenance Agreement Required: ☐ Yes ☒ No

☐ House/Mod. Home ☒ Mobile Home ☐ Business ☐ Other

No. Bedrooms 3 No. Bathrooms 2 No. Employees

☐ Slab ☒ Crawl Space ☐ Basement w/plumbing ☐ Basement wo/plumbing

Water Supply: ☐ Individual ☐ Community ☒ Public


Comments:

Replaces Permit issued To David Bates 12-12-95


Comments:

444'

INITIAL SITE SKETCH

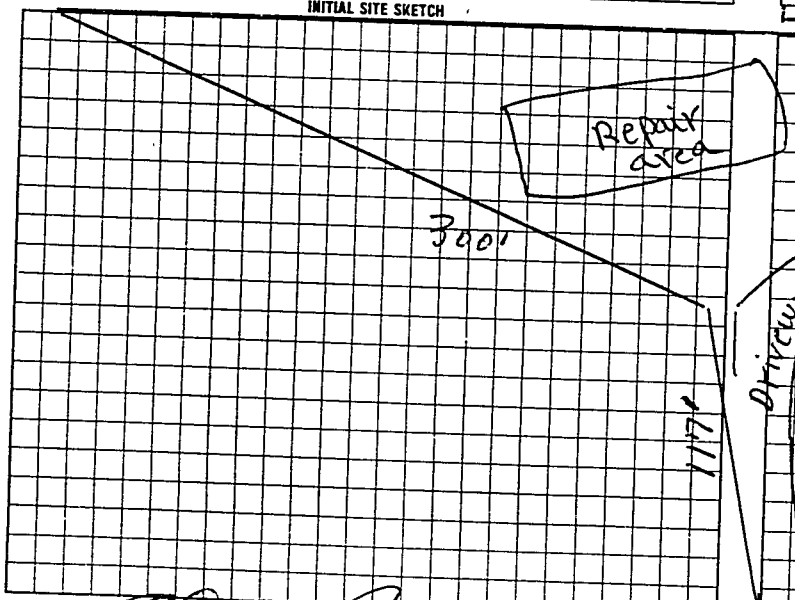

AS BUILT SKETCH

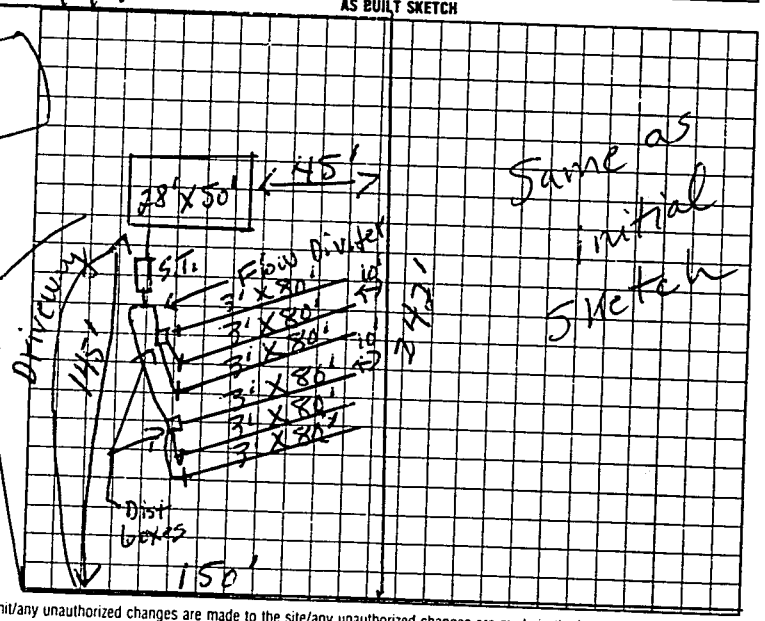

I understand that this permit can be suspended or revoked if any false information is supplied toward securing the permit/any unauthorized changes are made to the site/any unauthorized changes are made in the installation of the system.

Signed:

Improvement Permit by: Authorization to count E.C. Moore date 6-17-96

Existing System Inspection by: E.C. Moore date 6-17-96

Installed by: G & M Enterprizes

Certificate of Completion by: date

Operation Permit by: E.C. Moore date 11-6-96

HEALTH DEPT COPY: WHITE INSPECTION COPY (FINAL): GREEN OWNER COPY (FINAL): YELLOW INSPECTION COPY (INITIAL): PINK OWNER COPY (INITIAL): GOLD

Authorization to count EXPIRES 6 months FROM ISSUE

050200