62076

IREDELL COUNTY HEALTH DEPARTMENT

STATESVILLE 704-878-5305 MOORESVILLE 704-664-5281

IMPROVEMENT PERMIT / CERTIFICATE OF COMPLETION / OPERATION PERMIT / EXISTING SYSTEM INSPECTION

PROPERTY DESCRIPTION NO. 22744 & 22471 DATE 11-16-95 TAX MAP NO. 8M-9-A-10 & 11 Watershed: ☐ Yes ☑ No

OWNER OR CONTRACTOR ERNEST H. RUNGE PHONE: Business Home 872-6645

ADDRESS 374 LONG ISLAND ROAD STATESVILLE, NC 28677

LOCATION I-40 W, TR OLD MOUNTAIN ROAD, TR CONIFER DRIVE, 6TH & 7TH LOT ON LEFT PAST PINE BARK COURT

SUBDIVISION PINE RIDGE EST. BLOCK / SECTION LOT 10 & 11 LOT AREA 1.246 ACRE SITE CLASS. PS DESIGN FLOW 360 L.T.A.R. 0.30 GPD/FT²

Septic Tank: 1000 Gallons; STB 821 Date 6-26-96 ☐ New System ☐ Repair System Type: I, II, III, IV, V, VI ☐ House/Mod. Home No. Bedrooms 3 Water Supply: ☐ Individual

Pump Tank: Gallons; PT Date ☑ Mobile Home No. Bathrooms 2 ☐ Community

Pump Make: Model Serial No. System Description: CONVENTIONAL GRAVITY ☐ Business No. Employees ☑ Public

Nitrification Field: No Fields 1 Square Feet 1200 Linear Feet 400 Repair System Description: CONVENTIONAL GRAVITY ☐ Other


No Lines 4 Trench Width 36" Max Trench Bottom Depth 18-36" Gravel Depth 12" Maintenance Agreement Required: ☐ Yes ☑ No

☐ Slab ☑ Crawl Space ☐ Basement w/plumbing ☐ Basement wo/plumbing

Comments: USE THREE FLOW DIVIDER TEES TO ACHIEVE EQUAL DISTRIBUTION INTO EACH OF FOUR LINES ② INSTALL LINES ON CONTOUR AS SHOWN, NO DEEPER THAN 36", 9' MINIMUM APART ON CENTERS

Comments:

INITIAL SITE SKETCH

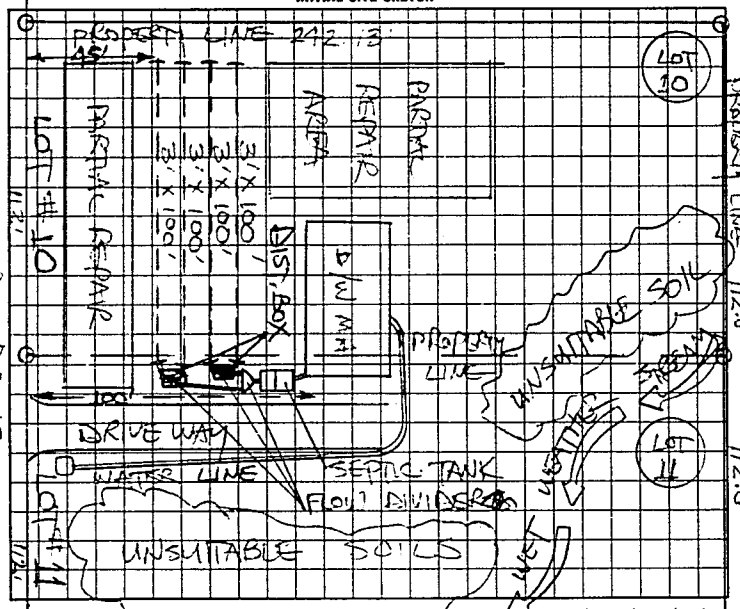

AS BUILT SKETCH

SYSTEM INSTALLED ACCORDING TO INITIAL SITE SKETCH

I understand that this permit can be suspended or revoked if any false information is supplied toward securing the permit/any unauthorized changes are made to the site/any unauthorized changes are made in the installation of the system.

AUTHORIZATION TO CONSTRUCT IS VALID FIVE (5) YEARS FROM DATE OF ISSUANCE. IMPROVEMENT PERMIT HAS NO EXPIRATION DATE

Signed:

Improvement Permit by: STEVE HENDRICK date 11-16-95

Authorization to Construct / Existing System Inspection by: STEVE HENDRICK date 4-10-96

Installed by: S & M ENTERPRISES

Certificate of Completion by: date

Operation Permit by: STEVE HENDRICK date 7-29-96

HEALTH DEPT. COPY WHITE INSPECTION COPY (FINAL) GREEN OWNER COPY (FINAL) YELLOW INSPECTION COPY (INITIAL) PINK OWNER COPY (INITIAL) GOLD

00203