IREDELL COUNTY HEALTH DEPARTMENT

STATESVILLE 704-878-5305 MOORESVILLE 704-664-5281

IMPROVEMENT PERMIT / AUTHORIZATION TO CONSTRUCT / OPERATION PERMIT / EXISTING SYSTEM INSPECTION

PERMIT # Repair PIN # 4704880141 DATE 3-6-09

OWNER or APPLICANT Hassell Reep PHONE: Business Home: 704 872 7997

OWNER or APPLICANT ADDRESS 1110 Island Ford Rd

LOCATION / DIRECTIONS 1116 Island Ford Rd

SUBDIVISION n/a BLOCK / SECTION n/a LOT # n/a LOT AREA 1.42 DESIGN FLOW 240 L.T.A.R. .3

Septic Tank 1000 Gallons: STB 760 Date 11-17-08

Pump Tank Gallons: P T Date

Pump Make Model Serial #

Nitrification Field No Fields 1 No Lines 3 Linear Feet 200 total

Trench Width 36" Max. Trench Bottom Depth 36" Gravel Depth n/a ☒ GRAVITY ☐ PRESSURE

☐ New System ☒ Repair ☐ Expansion System Type I II III IV V VI

System Description: 25% Gravity Reduction

Repair System Description: Base for Another 25% Red Gravity

Maintenance Agreement Required ☐ YES ☒ NO


☒ Residence No. Bedrooms 2 ☐ Business No. Persons ☐ Other No. Employees ☐ Slab ☒ Crawl Space ☐ Basement w/plumbing ☐ Basement w/o plumbing

Water Supply ☐ Private ☒ Public ☐ Community

Comments / Conditions

Comments / Conditions

INITIAL SITE SKETCH

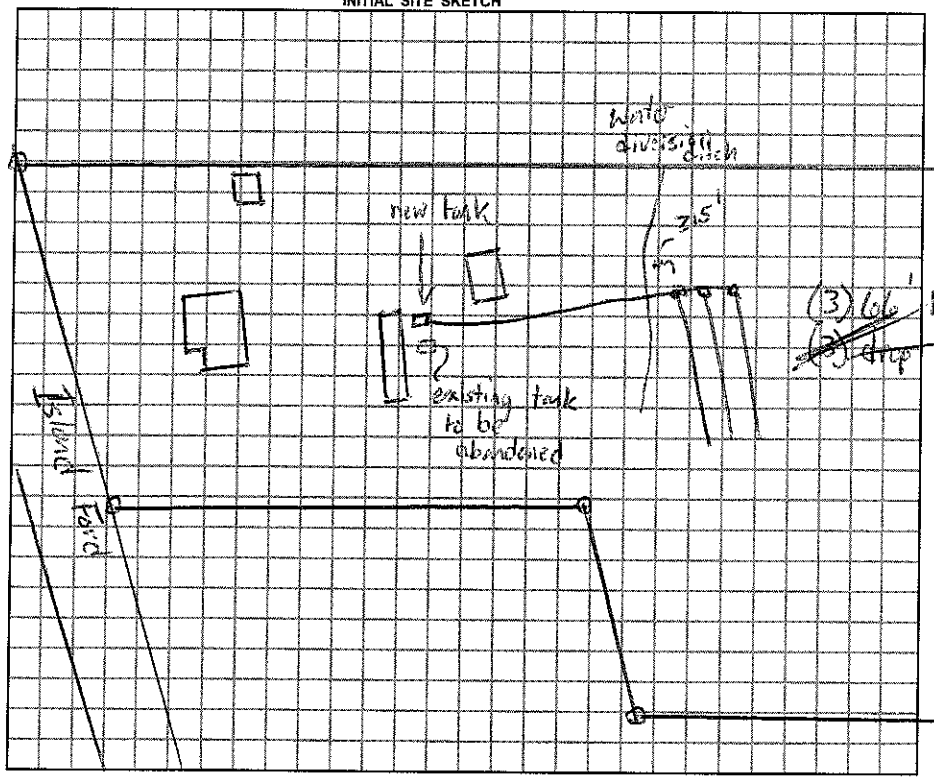

AS BUILT SKETCH

Permit can be suspended or revoked if any false information is supplied toward securing the permit / any unauthorized changes are made to the site / any unauthorized changes are made in the installation of the system.

☐ *IMPROVEMENT PERMIT w / plat valid without expiration.* ☒ *IMPROVEMENT PERMIT w / site plan valid for 60 mos.* ☒ *AUTHORIZATION TO CONSTRUCT valid for period equal to IMPROVEMENT PERMIT-not to exceed 60 mo.*

Owner / Applicant Signature: Date

Improvement Permit by: Date 3-6-9

Authorzation to Construct by: Date 3-6-9

YOU SHOULD CONTACT A LOCATOR SERVICE PRIOR TO ANY EXCAVATION.

Installed by: A-1 Backhoe

Operation Permit by: Date: 3-6-9

Existing System Inspected by: Date:

WHITE COPY Environmental Health YELLOW COPY (Final) Owner / Applicant PINK COPY (Initial) Owner / Applicant