IREDELL COUNTY HEALTH DEPARTMENT

Statesville Phone TR 3-7271 Mooresville Phone No. 664-5281

PERMIT TO INSTALL SEPTIC TANK

Permit No. 28 Permit Date 10-27 1977

Owner Espy Campbell (also Jenkins Bldg) Address Statesville NC

Installed By Harlee Lackey Address Stony Point N.C.


Location of Property Old Mountain Road About White Oaks - House on R. Across road from Beaulah Baptist Church.

Tank		Capacity		Length of Lines		Fixtures	
Block	( )	1000	(✓)	225'	(✓)	No. of Baths	(1½)
Precast	(✓)	1250	( )	250'	( )	Dishwasher	( )
		1500	( )	Other		Garbage Grdr.	( )
		Other				Other	

NOTIFY HEALTH DEPARTMENT AT LEAST EIGHT HOURS BEFORE TANK IS TO BE INSPECTED.

Final Inspection 10-27 1977 Approved (✓) Disapprcved ( )

Remarks Water from West Iredell Water Corp.

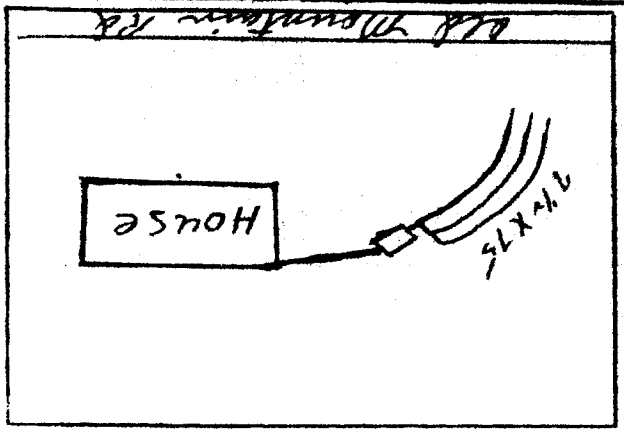

Sketch of Installation

E. C. Stevenson

Sanitarian