IREDELL COUNTY HEALTH DEPARTMENT

STATESVILLE 704-878-5305 MOORESVILLE 704-664-5281

IMPROVEMENT PERMIT / CERTIFICATE OF COMPLETION / OPERATION PERMIT / EXISTING SYSTEM INSPECTION

#22377 & 22162 57357

PROPERTY DESCRIPTION NO. 22162 // 22377 DATE 11-1-95 TAX MAP NO. 8M-A-69 (PART OF) Watershed: ☐ Yes ☑ No

OWNER OR CONTRACTOR ERNEST H. RUNGE PHONE: Business Home 872-6645

ADDRESS 374 LONG ISLAND ROAD, STATESVILLE, NC 28677

LOCATION I-40 W, TR OLD MTN. RD, TR CONIFER DRIVE, LAST TWO LOTS ON RIGHT BEFORE CUL-DE-SAC

SUBDIVISION PINE RIDGE BLOCK / SECTION LOT 17&18 LOT AREA 1.475 AC SITE CLASS PS DESIGN FLOW 360 L.T.A.R. 0.35 GPD/FT²

Septic Tank: 1000 Gallons; STB 821 Date 1-4-97

Pump Tank: Gallons; PT Date

Pump Make: Model Serial No.

Nitrification Field: No Fields 1 Square Feet 1035 Linear Feet 345

No. Lines 6 Trench Width 36" Max Trench Bottom Depth 18-36" Gravel Depth 12"

☑ New System ☐ Repair System Type: I, II, III, IV, V, VI

System Description: CONVENTIONAL GRAVITY LPP

Repair System Description:

Maintenance Agreement Required: ☐ Yes ☑ No

☐ House/Mod. Home ☑ Mobile Home ☐ Business ☐ Other

No. Bedrooms 3 No. Bathrooms 2 No. Employees


☐ Slab ☑ Crawl Space ☐ Basement w/plumbing ☐ Basement wo/plumbing

Water Supply: ☐ Individual ☐ Community ☑ Public

Comments: ① KEEP SYSTEM MINIMUM 5' FROM MIN. PROPERTY LINE ② USE FLOW DIVIDER TO SPLIT EFFLUENT INTO TWO DISTRIBUTION BOXES FEEDING THREE LINES EACH AS SHOWN. 10' FROM

Comments:

INITIAL SITE SKETCH

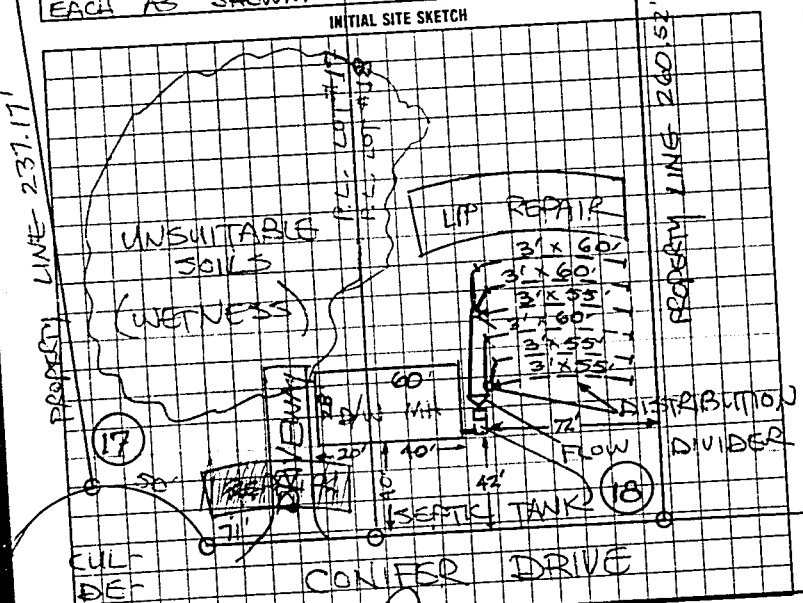

AS BUILT SKETCH

SYSTEM INSTALLED ACCORDING TO INITAL SITE SKETCH

I understand that this permit can be suspended or revoked if any false information is supplied toward securing the permit/any unauthorized changes are made to the site/any unauthorized changes are made in the installation of the system. AUTHORIZATION TO CONSTRUCT IS VALID FIVE (5) YEARS FROM DATE OF ISSUANCE.

Signed: S & M ENTERPRISES

Improvement Permit by: STEVE HEDRICK date 11-1-95

AUTHORIZATION TO CONSTRUCT Existing System Inspection by: STEVE HEDRICK date 4-10-96

Installed by: date

Certificate of Completion by: date

Operation Permit by: STEVE HEDRICK date 2-12-97

HEALTH DEPT. COPY: WHITE INSPECTION COPY (FINAL): GREEN OWNER COPY (FINAL): YELLOW INSPECTION COPY (INITIAL): PINK OWNER COPY (INITIAL): GOLD

IMPROVEMENT PERMIT HAS NO EXPIRATION DATE.

0 0 2 0 1 1