Ray Barnes on Completion

61583

IREDELL COUNTY HEALTH DEPARTMENT

STATESVILLE 704-878-5305 MOORESVILLE 704-664-5281

IMPROVEMENT PERMIT / CERTIFICATE OF COMPLETION / OPERATION PERMIT / EXISTING SYSTEM INSPECTION

PROPERTY DESCRIPTION NO. 23072 DATE 2-7-96 TAX MAP NO. 8M-9-A-13 Watershed: Yes ✓ No

OWNER OR CONTRACTOR ERNEST H. RUNGE PHONE: Business Home 872-6645

ADDRESS 374 LONG ISLAND ROAD, STATESVILLE, NC 28677

LOCATION I-40 W, TR OLD MTN. RD, TR CONIFER DRIVE, 9th LOT ON LEFT PAST PINE BARK COURT

SUBDIVISION PINE RIDGE BLOCK / SECTION LOT 13 LOT AREA 112'x242' SITE CLASS PS DESIGN FLOW 360 L.T.A.R 0.30 GPD/FT²

Septic Tank: 1000 Gallons; STB 821 Date 6-21-96
Pump Tank: Gallons; PT Date
Pump Make: Model Serial No.
Nitrification Field: No Fields 1 Square Feet 1200 Linear Feet 400
No Lines 5 Trench Width 36" Max Trench Bottom Depth 18-36" Gravel Depth 12"

✓ New System Repair System Type I II III IV V VI
System Description: CONVENTIONAL GRAVITY
Repair System Description: CONV. PUMP
Maintenance Agreement Required: Yes ✓ No

Slab ✓ Crawl Space Basement w/plumbing Basement wo/plumbing


✓ House/Mod. Home No Bedrooms 3
✓ Mobile Home No Bathrooms 2
Business No Employees
Other

Water Supply
☐ Individual
☐ Community
☑ Public

Comments:

Comments:

INITIAL SITE SKETCH

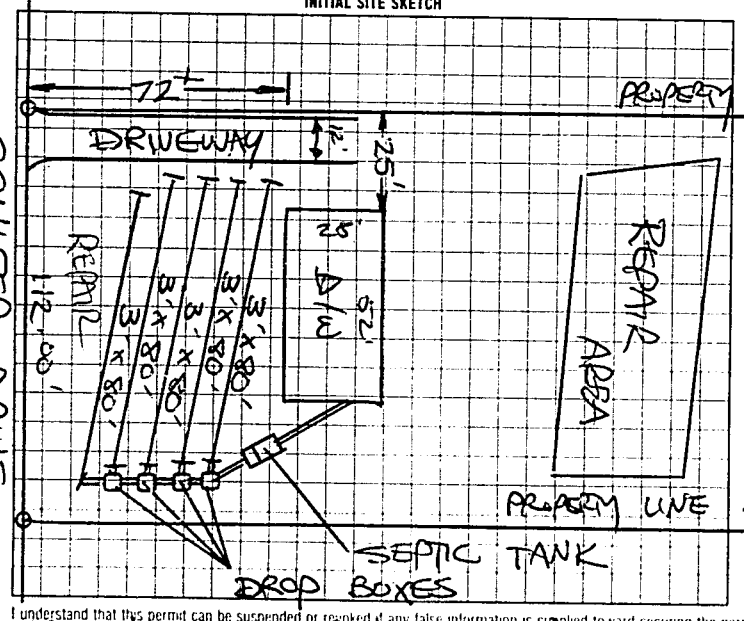

AS BUILT SKETCH

SYSTEM INSTALLED ACCORDING TO INITIAL SITE SKETCH

I understand that this permit can be suspended or revoked if any false information is supplied toward securing the permit, any unauthorized changes are made to the site, any unauthorized changes are made in the installation of the system.

AUTHORIZATION TO CONSTRUCT IS VALID FIVE (5) YEARS FROM ~~DATE OF ISSUANCE~~. IMPROVEMENT PERMIT HAS NO EXPIRATION DATE.

Signed

Improvement Permit by: STEVE HEDRICK date 2-7-96 Installed by: G&M ENTERPRISES

~~AUTHORIZATION TO CONSTRUCT~~ Existing System Inspection by: STEVE HEDRICK date 4-10-96 ~~Certificate of Completion by~~ Operation Permit by: STEVE HEDRICK date 7-24-96

HEALTH DEPT COPY WHITE | INSPECTION COPY (FINAL) GREEN | OWNER COPY (FINAL) YELLOW | INSPECTION COPY (INITIAL) PINK | OWNER COPY (INITIAL) GOLD

080200