IREDELL COUNTY HEALTH DEPARTMENT

STATESVILLE 704-878-5305 MOORESVILLE 704-664-5281

IMPROVEMENT PERMIT / CERTIFICATE OF COMPLETION / OPERATION PERMIT / EXISTING SYSTEM INSPECTION

PROPERTY DESCRIPTION NO. 25901 DATE 1-15-97 TAX MAP NO. 8M-A-69

OWNER OR CONTRACTOR Ernest Runge PHONE: Business 872-6645 Home

ADDRESS 354 Long Island Rd Statesville NC Watershed: ☐ Yes ☒ No

LOCATION I-40 TR Old Mtn Rd TR Conifer Drive on Left at Cul de Sac

SUBDIVISION Pine Ridge Est BLOCK / SECTION LOT 14 LOT AREA 0.7ac. SITE CLASS. P/S DESIGN FLOW 360 L.T.A.R. 0.35

Septic Tank: 1000 Gallons; STB 801 Date 5-2-97

Pump Tank: Gallons; PT Date

Pump Make: Model Serial No.

Nitrification Field: No Fields 1 Square Feet 1028 Linear Feet 350

No Lines 5 Trench Width 36in Max Trench Bottom Depth 36in Gravel Depth 12in

☒ New System ☐ Repair System Type: I, II, III, IV, V, VI

System Description: Gravity Conventional

Repair System Description: Pump Chamber

Maintenance Agreement Required: ☐ Yes ☒ No

☐ House/Mod. Home ☒ Mobile Home ☐ Business ☐ Other

No. Bedrooms 3 No. Bathrooms 2 No. Employees


Water Supply: ☐ Individual ☐ Community ☒ Public

☐ Slab ☒ Crawl Space ☐ Basement w/plumbing ☐ Basement wo/plumbing


Comments: Keep lines on contour, 9ft on center

Comments:

INITIAL SITE SKETCH

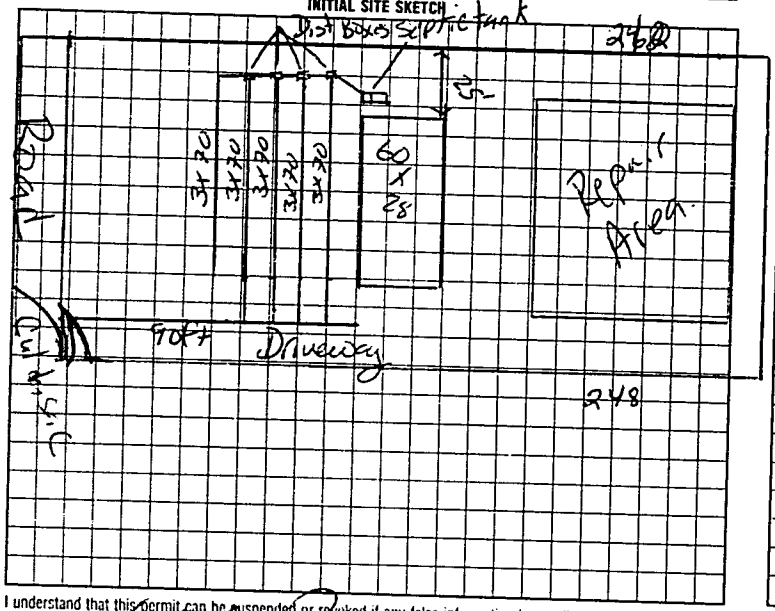

AS BUILT SKETCH

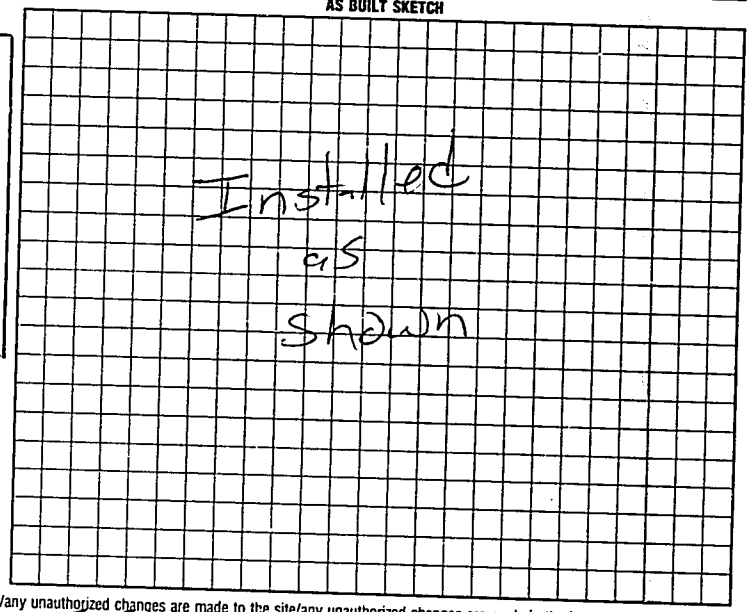

I understand that this permit can be suspended or revoked if any false information is supplied toward securing the permit/any unauthorized changes are made to the site/any unauthorized changes are made in the installation of the system. Improvement Permit is valid for 60 months from date of issuance. Authorization to construct expires 5yr from issue date

Signed:

Improvement Permit by: Mark C. Ott RS date 1-15-97

~~Existing System~~ Inspection by: Authorized by Tony Iacono Mark C. Ott RS date 1-15-97

Installed by: G & M Enterprises

Certificate of Completion by: date

Operation Permit by: Mark C. Ott RS date 5-29-97

HEALTH DEPT. COPY: WHITE INSPECTION COPY (FINAL) GREEN OWNER COPY (FINAL) YELLOW INSPECTION COPY (INITIAL) PINK OWNER COPY (INITIAL) GOLD