IREDELL COUNTY HEALTH DEPARTMENT

Statesville Phone TR 3-7271 Mooresville Phone No. 664-5281

PERMIT TO INSTALL SEPTIC TANK

Permit No. 371 Permit Date 5-21 1973

Owner West Iredell High School Address Statesville NC

Installed By Henry Sigmon Address Statesville N.C.


Location of Property Island Ford Rd.

Tank		Capacity		Length of Lines		Fixtures	
Block	( )	1000	( )	225'	( )	No. of Baths	( )
Precast	(✓)	1250	( )	250'	( )	Dishwasher	( )
		1500	( )	Other 175		Garbage Grdr.	( )
		Other 800				Other	

NOTIFY HEALTH DEPARTMENT AT LEAST EIGHT HOURS BEFORE TANK IS TO BE INSPECTED.

Final Inspection 5-21 1973 Approved (✓) Disapproved ( )

Remarks

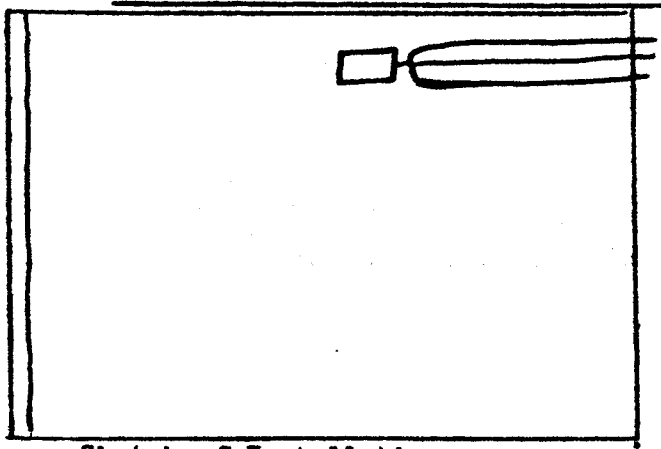

Sketch of Installation

This is a temporary installation. For use by Construction Workers and Will be abandoned when job is finished

E. G. Stevenson

Sanitarian