IREDELL COUNTY HEALTH DEPARTMENT

Statesville Phone TR 3-7271 Mooresville Phone No. 664-5281

PERMIT TO INSTALL SEPTIC TANK

Permit No. 1 4 Permit Date 1-31 1973

Owner H.K. JOHNSON CONST. CO - WEST IREDELL SCHOOL Address STATESVILLE. NC

Installed By Raymond Adams Address Hiddnite, NC

Location of Property Island Ford Rd


WEST IREDELL School Site

Tank		Capacity		Length of Lines		Fixtures	
Block	( )	1000	(✓)	225'	(✓)	No. of Baths	(1)
Precast	(✓)	1250	( )	250'	( )	Dishwasher	( )
		1500	( )	Other		Garbage Grdr.	( )
		Other				Other	

NOTIFY HEALTH DEPARTMENT AT LEAST EIGHT HOURS BEFORE TANK IS TO BE INSPECTED.

Final Inspection 1-31 1973 Approved (✓) Disapprcved ( )

Remarks WEST IREDELL WATER -

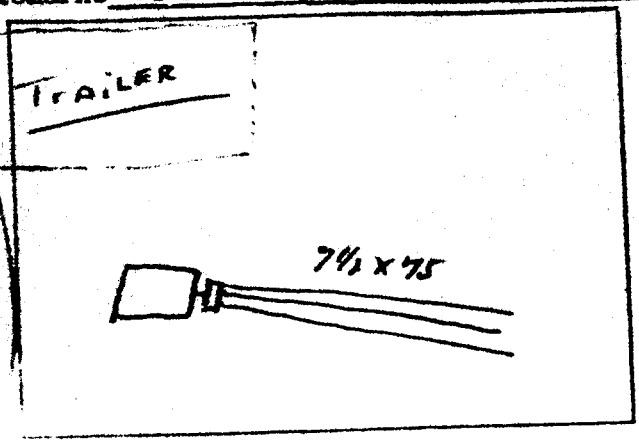

Sketch of Installation

Sanitarian