IREDELL COUNTY HEALTH DEPARTMENT

STATESVILLE 704-878-5305 MOORESVILLE 704-664-5281

IMPROVEMENT PERMIT / CERTIFICATE OF COMPLETION / OPERATION PERMIT / EXISTING SYSTEM INSPECTION

PROPERTY DESCRIPTION NO. 16248 DATE 6-7-93 TAX MAP NO. Pt. of 85-A-9A

OWNER OR CONTRACTOR James D. McMillan PHONE: Business Home

ADDRESS

LOCATION I40W TR Old Mtn. Rd. Lot on R across from Old Miller Farm Rd.

SUBDIVISION NA BLOCK / SECTION LOT LOT AREA .572 acres SITE CLASS. P.S L.T.A.R. .35gpd/ft²

Water Supply: ☑ Individual ☐ Community ☐ Public Well

Septic Tank: 1000 Gallons; STB 1012 Date 3-27-93

Pump Tank: Gallons; PT Date

Nitrification Field: No Fields 1 Square Feet 690 Linear Feet 230'

No Lines 2 Trench Width 36" Trench Depth 36" Gravel Depth 12"

☑ New System ☐ Repair System Type: I. II. III. IV. V. VI

System Description: Conventional, gravity fed

Repair System Description: " "

Maintenance Agreement Required: ☐ Yes ☑ No

☐ House/Mod. Home ☑ Mobile Home ☐ Business ☐ Other

No. Bedrooms 2 No. Bathrooms 1.5 No. Employees —

☐ Slab ☑ Crawl Space ☐ Basement w/plumbing ☐ Basement wo/plumbing

Garbage Disposal: ☐ Yes ☑ No


Auto. Dishwasher: ☐ Yes ☑ No

Auto. Washing Machine: ☑ Yes ☐ No


Other

Comments Keep MH min. 5' from any part of septic system. Keep water line min. 10' from any septic system. 100% Repair below system, conventional, gravity fed.

INITIAL SITE SKETCH

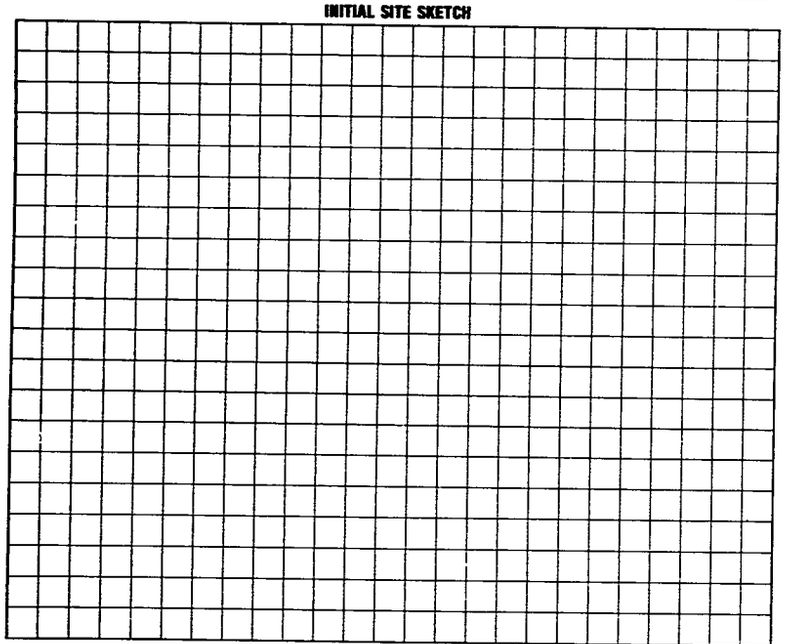

AS BUILT SKETCH Property Line

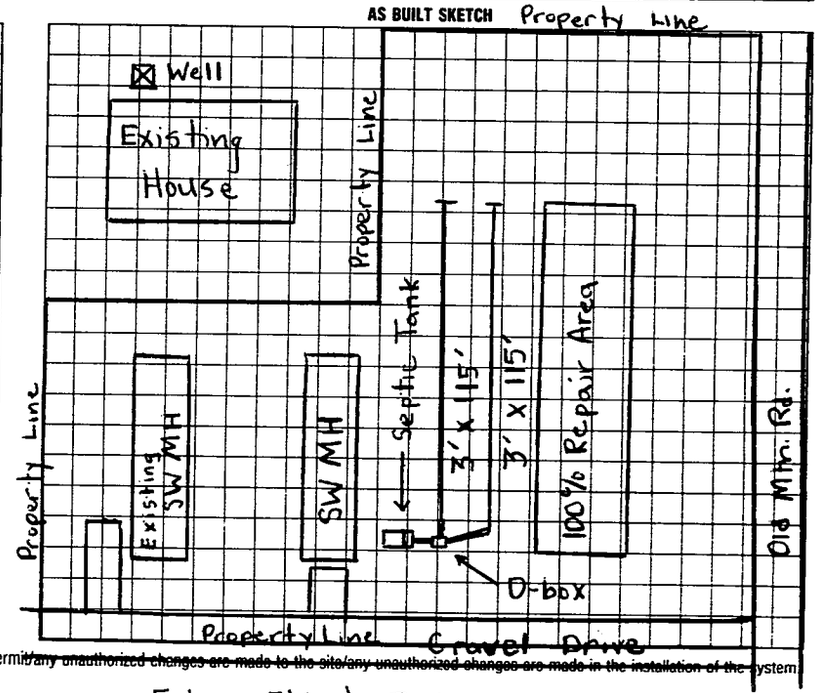

I understand that this permit can be suspended or revoked if any false information is supplied toward securing the permit. ~~any unauthorized changes are made to the site/any unauthorized changes are made in the installation of the system~~ Improvement Permit is valid for 60 months from date of issuance.

Signed:

Improvement Permit by: Michael D. Dennis date 5-10-93

Existing System Inspection by: date

Installed by: Esker Elder's Backhoe

Certificate of Completion by: Michael D. Dennis date 6-7-93

Operation Permit by: date

HEALTH DEPT. COPY: WHITE INSPECTION COPY (FINAL): GREEN OWNER COPY (FINAL): YELLOW INSPECTION COPY (INITIAL): PINK OWNER COPY (INITIAL): GOLD