IREDELL COUNTY HEALTH DEPARTMENT

STATESVILLE 704-878-5305 MOORESVILLE 704-664-5281

IMPROVEMENT PERMIT / AUTHORIZATION TO CONSTRUCT / OPERATION PERMIT / EXISTING SYSTEM INSPECTION

PERMIT# 089935 PIN# 4705050441 PT DATE 7-10-2000

OWNER OR CONTRACTOR Earlie Hager PHONE: Business _____ Home 876-3154

ADDRESS 524 Cove Gap Rd. Statesville, NC

LOCATION Hwy 64 TL Lippard Farm TR Massey Deal TR Waugh Farm at End

SUBDIVISION Ben's Estates BLOCK / SECTION _____ LOT 4 LOT AREA .46 Acre SITE CLASS PS DESIGN FLOW 360 gpd L.T.A.R. .3-.4 (SAP is .4) T-155 used

Septic Tank: 1000 Gallons; STB 160 Date 6-5-00

Pump Tank: _____ Gallons; PT _____ Date _____

Pump Make: _____ Model _____ Serial No. _____

Nitrification Field: No Fields 1 Square Feet 810' Linear Feet 270'

No Lines 6 at 45' Trench Width 36" Max Trench Bottom Depth 36" Gravel Depth N/A

[X] New System [ ] Repair System Type: I, II, III, IV, V, VI

System Description: Gravity - 25% Reduction

Repair System Description Gravity/Pump - Innovative

Maintenance Agreement Required [ ] Yes [X] No

[ ] Slab [X] Crawl Space [ ] Basement w/plumbing [ ] Basement wo/plumbing

[ ] House/Mod. Home No. Bedrooms 3

[X] Mobile Home No. Bathrooms 2

[ ] Business No. Employees _____


[ ] Other _____

Water Supply: [X] Individual Shared [ ] Public on Lot #6 [ ] Community


Comments/Conditions: Keep Septic System at least 10' From PL & 5' From Mobile Home.

Comments/Conditions: Installer may use "Drop boxes" in.

INITIAL SITE SKETCH Scale 1:60'

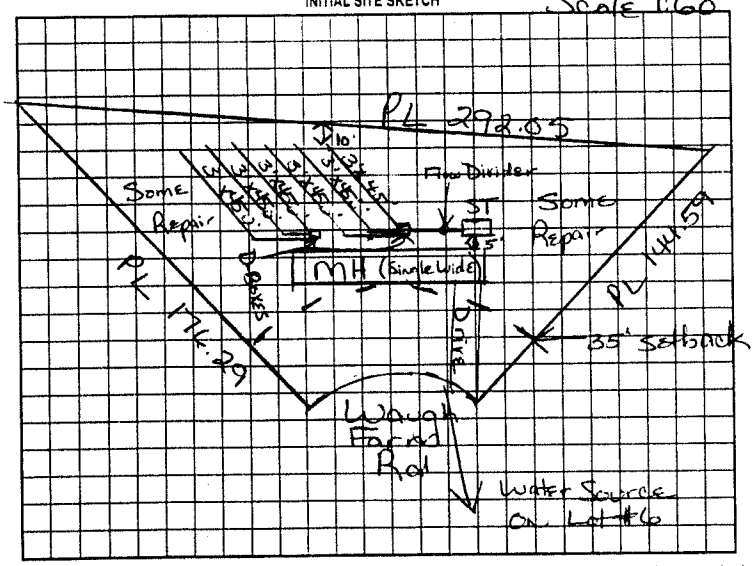

AS BUILT SKETCH

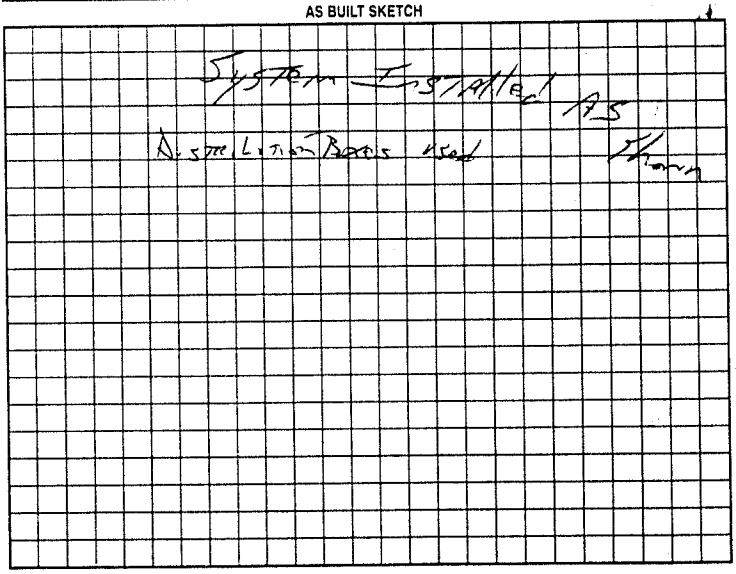

Permit can be suspended or revoked if any false information is supplied toward securing the permit/any unauthorized changes are made to the site/any unauthorized changes are made in the installation of the system. Improvement Permit with plat valid without expiration. Improvement Permit with site plan valid for sixty months. Authorization to Construct is valid for a period equal to that of Improvement Permit – not to exceed sixty months.

Signed: Earlie Hager date 7-11-2000 Installed by: Earlie Hager

Improvement Permit by: Maintained Dotson RS date 7/10/2000 Operation Permit by: Joe Bitter date July 26 2000

Authorization to Construct by: Maintained Dotson RS date 7/10/2000 Existing System Inspection by: _____ date _____

HEALTH DEPT. COPY: WHITE OWNER COPY (FINAL) YELLOW OWNER COPY (INITIAL): PINK