IREDELL COUNTY HEALTH DEPARTMENT

STATESVILLE 704-878-5305 MOORESVILLE 704-664-5281

IMPROVEMENT PERMIT / AUTHORIZATION TO CONSTRUCT / OPERATION PERMIT / EXISTING SYSTEM INSPECTION

PERMIT# 0899.31 PIN# 4705050 441 DT DATE 7/10/2000

OWNER OR CONTRACTOR Earlie Hager PHONE: Business 876-3154 Home

ADDRESS 524 Cove Gap Rd Statesville, NC 28625

LOCATION Hwy 64 TL Lippard Farm TR Massey Deal TL Waugh Farm Near End on right

SUBDIVISION Bents Estates BLOCK / SECTION LOT 7 LOT AREA .5 Acre SITE CLASS PS DESIGN FLOW 360gpd L.T.A.R. .3

Septic Tank: 1000 Gallons; STB 160 Date 6-1-00
Pump Tank: Gallons; PT Date
Pump Make: Model Serial No.
Nitrification Field: No Fields 1 Square Feet 900' Linear Feet 300'
No Lines 3 at 100' Trench Width 36" Max Trench Bottom Depth 36"

[X] New System [ ] Repair System Type: I II III IV V VI
System Description: Gravity - 25% Reduction
Repair System Description: Grav/Pump - Innovative
Maintenance Agreement Required: [ ] Yes [X] No

[ ] House/Mod. Home No. Bedrooms 3
[X] Mobile Home No. Bathrooms 2
[ ] Business No. Employees
[ ] Other


[ ] Slab [X] Crawl Space [ ] Basement w/plumbing [ ] Basement wo/plumbing

Water Supply: [X] Individual Shared Well [ ] Public [ ] Community


Comments/Conditions: Keep Septic System at least 10' from PL, 5' from House & 100' from Existing well

Comments/Conditions: Water source - Shared well on Lot #6 next door. line thru middle line Deeper than 36 - Knoll

INITIAL SITE SKETCH

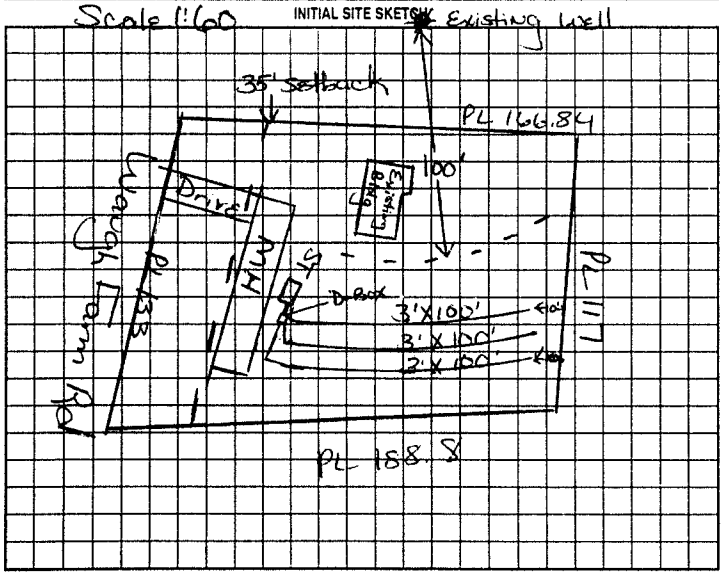

AS BUILT SKETCH

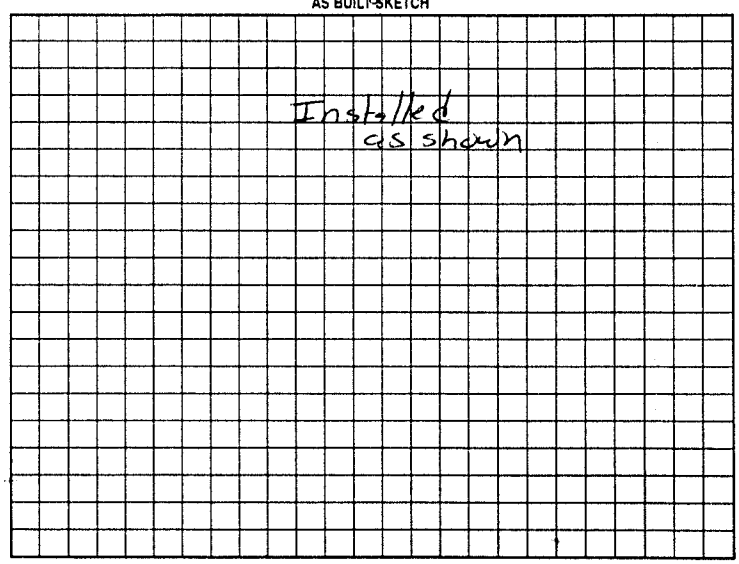

Permit can be suspended or revoked if any false information is supplied toward securing the permit/any unauthorized changes are made to the site/any unauthorized changes are made in the installation of the system. Improvement Permit with plat valid without expiration. Improvement Permit with site plan valid for sixty months. Authorization to Construct is valid for a period equal to that of Improvement Permit – not to exceed sixty months.

Signed: Earlie Hager date 7-11-2000 Installed by: Self

Improvement Permit by: Mark Patterson R.S. date 7/10/2000 Operation Permit by: Mark C. Ott RS date 7-25-00

Authorization to Construct by: Mark Patterson R.S. date 7/10/2000 Existing System Inspection by: date

HEALTH DEPT. COPY: WHITE OWNER COPY (FINAL): YELLOW OWNER COPY (INITIAL): PINK