IREDELL COUNTY HEALTH DEPARTMENT

STATESVILLE 704-878-5305 MOORESVILLE 704-664-5281

IMPROVEMENT PERMIT / AUTHORIZATION TO CONSTRUCT / OPERATION PERMIT / EXISTING SYSTEM INSPECTION

PERMIT# Repair PIN# 4705 05 0441 DATE Apr. 1, 99

OWNER OR CONTRACTOR Jerry Peak PHONE: Business Home 873 0935

ADDRESS 172 Waugh Farm Rd Statesville

LOCATION Oldnt Rd (R) Massey Dean (L) Waugh Farm End .5 Rd

SUBDIVISION BLOCK / SECTION LOT LOT AREA SITE CLASS PS DESIGN FLOW 360 L.T.A.R. .35

Septic Tank: 1000 Gallons: STB 1012 Date 2-29-99

Pump Tank: Gallons: PT Date

Pump Make: Model Serial No.

Nitrification Field: No Fields 1 Square Feet 1028 Linear Feet 350

No Lines 2 Trench Width 36" Max Trench Bottom Depth 36" Gravel Depth 12"

☐ New System ☑ Repair System Type: I (II) III. IV. V. VI

System Description: Conv Gravity

Repair System Description: Pump

Maintenance Agreement Required: ☐ Yes ☑ No

☐ Slab ☑ Crawl Space ☐ Basement w/plumbing ☐ Basement wo/plumbing

☑ House/Mod. Home No. Bedrooms 3

☐ Mobile Home No. Bathrooms 2

☐ Business No. Employees

☐ Other

Water Supply: ☑ Individual ☐ Public ☐ Community Well


Comments:/Conditions: INSTALL lines on Contour Call 928 2030

Keep Septic System 50ft from well If Any Questions


Keep Septic Lines out of Farm Road Before Installing

Comments: Conditions

INITIAL SITE SKETCH

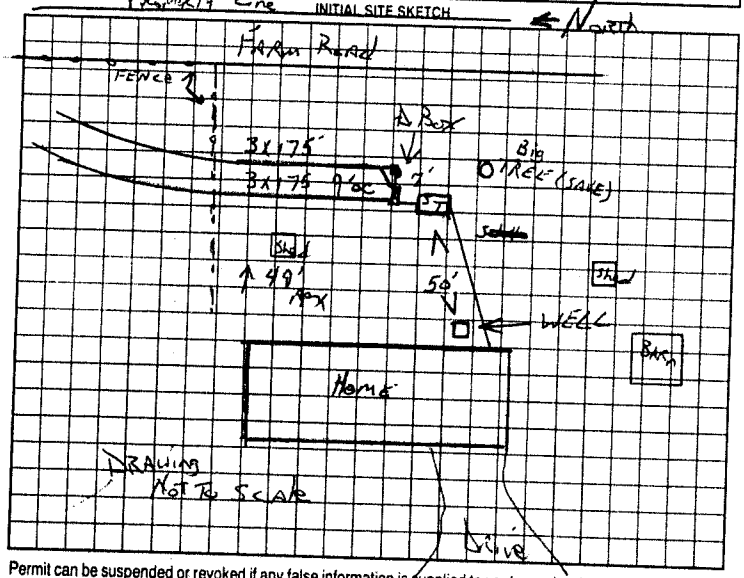

AS BUILT SKETCH

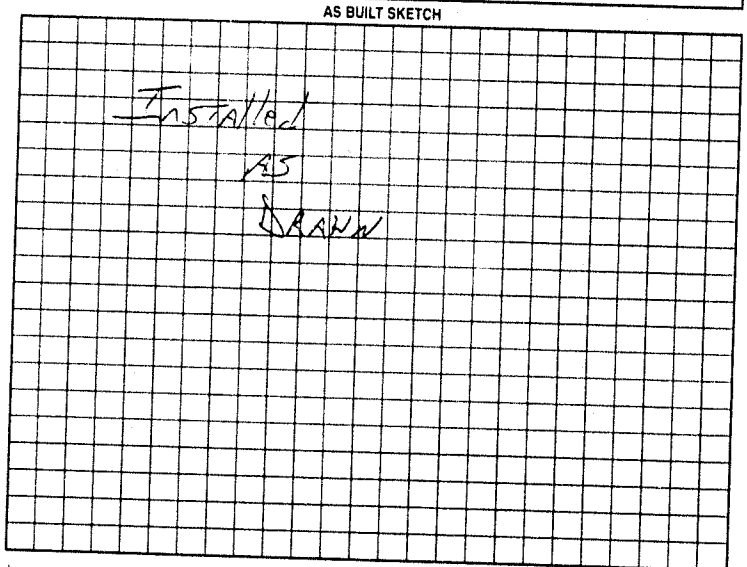

Permit can be suspended or revoked if any false information is supplied toward securing the permit/any unauthorized changes are made to the site/any unauthorized changes are made in the installation of the system. Improvement Permit with plat valid without expiration. Improvement Permit with site plan valid for sixty months. Authorization to Construct is valid for a period equal to that of Improvement Permit – not to exceed sixty months.

Signed: Jerry A Peak date 4-1-99 Installed by: A1 Backhoe

Improvement Permit by: JC Potter date 4.1.99 Operation Permit by: JC Potter date 4.23.99

Authorization to Construct by: JC Potter date 4.1.99 Existing System Inspection by: date

HEALTH DEPT COPY WHITE OWNER COPY (FINAL) YELLOW OWNER COPY (INITIAL) PINK