IREDELL COUNTY HEALTH DEPARTMENT

STATESVILLE 704-878-5305 · MOORESVILLE 704-664-5281

IMPROVEMENT PERMIT / AUTHORIZATION TO CONSTRUCT / OPERATION PERMIT / EXISTING SYSTEM INSPECTION

PERMIT# 073032 PIN# 4705 11 0995

OWNER OR CONTRACTOR Clyde Hall Enterprises PHONE: Business 585 2428 Home DATE 5-6-98

ADDRESS 268 Finley Farm Rd

LOCATION I-40 W TR ONR TR Hallmark Est Rt 1/4mi left

SUBDIVISION Hallmark Est. BLOCK / SECTION LOT 11 LOT AREA 30,000 SF SITE CLASS. PS DESIGN FLOW 360 L.T.A.R. .34

Septic Tank: 1000 Gallons; STB 1012 Date 5-8-98
Pump Tank: Gallons; PT Date
Pump Make: Model Serial No.
Nitrification Field: No Fields 1 Square Feet 1080 Linear Feet 360
No Lines 5 Trench Width 36" Max Trench Bottom Depth 36" Gravel Depth 12"

☒ New System ☐ Repair System Type: I (II) III, IV, V, V!
System Description: Conv. Gravity
Repair System Description: Pump To Chambers
Maintenance Agreement Required: ☐ Yes ☒ No


☐ House/Mod. Home No. Bedrooms 3
☒ Mobile Home No. Bathrooms 2
☐ Business No. Employees
☐ Other
☐ Slab ☒ Crawl Space ☐ Basement w/plumbing ☐ Basement wo/plumbing

Water Supply:
☐ Individual
☐ Public
☐ Community
West Iredell Water Corp.


Comments:/Conditions:

Drop boxes

INITIAL SITE SKETCH

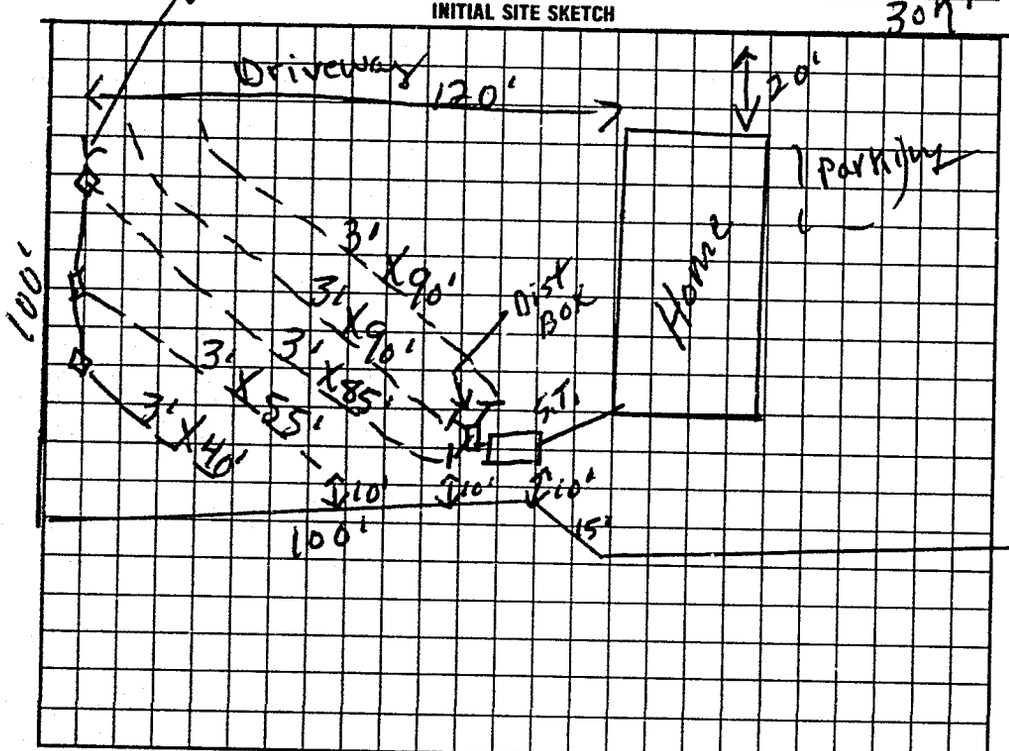

AS BUILT SKETCH

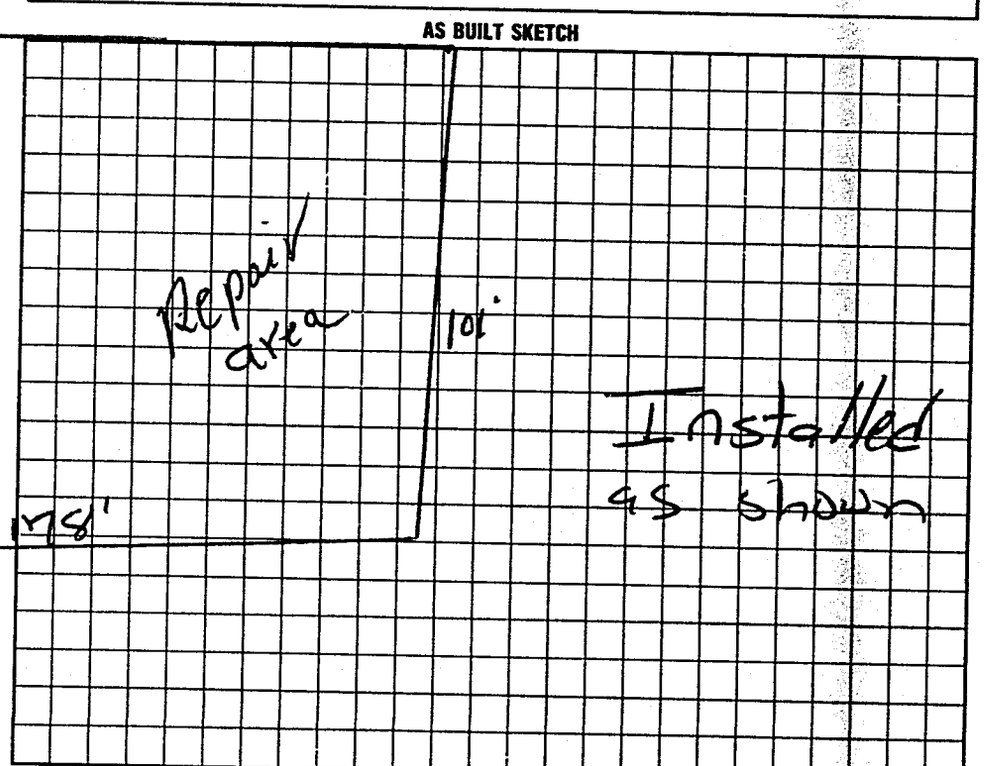

I understand that this permit can be suspended or revoked if any false information is supplied toward securing the permit/any unauthorized changes are made to the site/any unauthorized changes are made in the installation of the system. Improvement Permit with plat valid without expiration. Improvement Permit with site plan valid for sixty months. Authorization to Construct is valid for a period equal to that of Improvement Permit – not to exceed sixty months.

Signed: Dawn Stinchcomb date

Improvement Permit by: P.C. Moore date 5-6-98

Authorization to Construct by: P.C. Moore date 5-6-98

Installed by: Donald Lackey

Operation Permit by: Mat Conlons date 7-17-98

Existing System Inspection by: date

HEALTH DEPT. COPY: WHITE · INSPECTION COPY (FINAL): GREEN · OWNER COPY (FINAL): YELLOW · INSPECTION COPY (INITIAL): PINK · OWNER COPY (INITIAL): GOLD