IREDELL COUNTY HEALTH DEPARTMENT

STATESVILLE 704-878-5305 MOORESVILLE 704-664-5281

IMPROVEMENT PERMIT / CERTIFICATE OF COMPLETION / OPERATION PERMIT / EXISTING SYSTEM INSPECTION

PROPERTY DESCRIPTION NO. 070471 DATE 11-18-97 TAX MAP NO. 4705 14 7229 Watershed: ☐ Yes ☒ No

OWNER OR CONTRACTOR ROGER D. DIXON PHONE: Business Home 838-2184

ADDRESS 125 VILLAGE DRIVE, STATESVILLE NC 28677

LOCATION I-40 W, TR OLD MTN. RD TO T, BEFORE BUADY LANE, ~300' OFF ROAD

SUBDIVISION MASSEY HILL BLOCK / SECTION LOT 2 LOT AREA 2 ACRES SITE CLASS PS DESIGN FLOW 480 L.T.A.R. 0.30 GPD/FT²

Septic Tank: 1000 Gallons; STB 1012 Date 9-4-97

Pump Tank: ____ Gallons; PT ____ Date ____

Pump Make: ____ Model ____ Serial No. ____

Nitrification Field: No Fields 1 Square Feet EQ. TO 600 Linear Feet 533

No Lines FOUR Trench Width 36" Max Trench Bottom Depth 36" Gravel Depth 12"

☒ New System ☐ Repair System Type: I II III IV V VI

System Description: CONVENTIONAL GRAVITY

Repair System Description: CONV. GRAVITY

Maintenance Agreement Required: ☐ Yes ☒ No

☐ House/Mod. Home ☒ Mobile Home ☐ Business ☐ Other

No. Bedrooms 4 No. Bathrooms 2 No. Employees ____


☐ Slab ☒ Crawl Space ☐ Basement w/plumbing ☐ Basement wo/plumbing

Water Supply: ☐ Individual ☐ Community ☒ Public


Comments: ① KEEP SYSTEM MINIMUM 10' FROM WATER LINE. ② SCOUR TRENCH SIDEWALLS WHERE SMEARING OCCURS.

Comments:

INITIAL SITE SKETCH

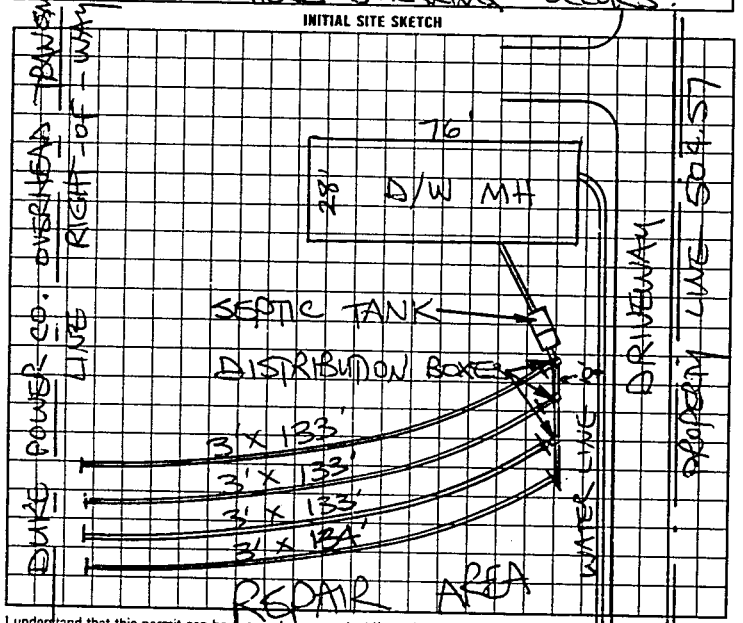

AS BUILT SKETCH

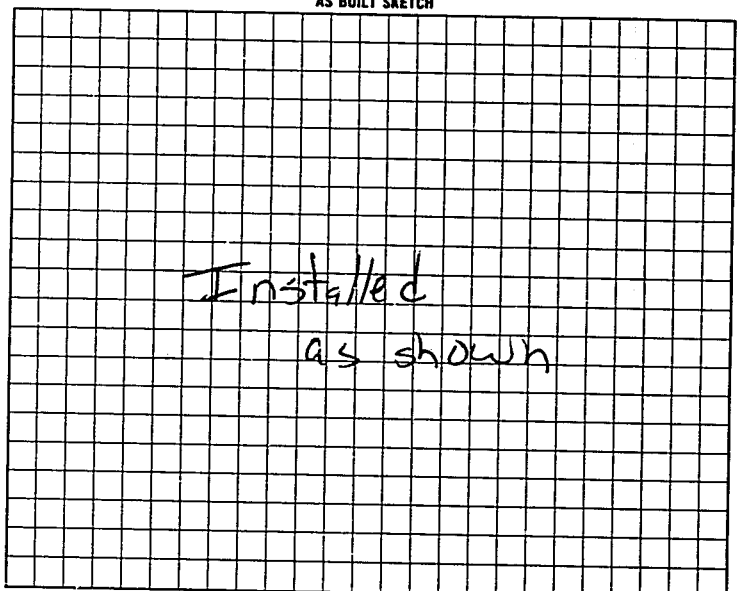

I understand that this permit can be suspended or revoked if any false information is supplied toward securing the permit/any unauthorized changes are made to the site/any unauthorized changes are made in the installation of the system. Improvement Permit is valid for 60 months from date of issuance. AUTHORIZATION TO CONSTRUCT IS VALID FOR 60 MONTHS FROM DATE OF ISSUANCE.

Signed: J. Russell Dixon

Improvement Permit by: STEVE HENDRICK date 11-18-97

AUTH. TO CONST.

Existing System Inspection by: STEVE HENDRICK date 11-18-97

Installed by: A-1 Backhoe

~~Certificate of Completion by:~~ ____ date ____

Operation Permit by: Mark C. Ortz RS date 12-3-97

HEALTH DEPT COPY: WHITE INSPECTION COPY (FINAL): GREEN OWNER COPY (FINAL): YELLOW INSPECTION COPY (INITIAL): PINK OWNER COPY (INITIAL): GOLD