IREDELL COUNTY HEALTH DEPARTMENT

STATESVILLE 704-878-5305 (C1) MOORESVILLE 704-664-5281

IMPROVEMENT PERMIT / AUTHORIZATION TO CONSTRUCT / OPERATION PERMIT / EXISTING SYSTEM INSPECTION

PERMIT# 116806 PIN# 4705-21-0441 DATE 11/12/03

OWNER OR CONTRACTOR Thomas Benfield PHONE: Business — Home (704) 876-6702

ADDRESS 2423 Old Mtn Rd Statesville N.C. 28625

LOCATION I-40 W, @ Old Mtn Road, past Bradford X-roads, go 1½ miles, @ ow gravel drive @ Platt Wilkins Farm Sign (off Road ¼ mile)

SUBDIVISION — BLOCK / SECTION — LOT — LOT AREA 30.78 Acres SITE CLASS P5 DESIGN FLOW 360 L.T.A.R. .25 gpd/ft2

Septic Tank: 1000 Gallons; STB 1012 Date 5-14-04
Pump Tank: — Gallons; PT — Date —
Pump Make: — Model — Serial No. —
Nitrification Field: No Fields 1 Square Feet 1920 Linear Feet 480
No Lines 5 Trench Width 36" Max Trench Bottom Depth 30" Gravel Depth 12

☒ New System ☐ Repair System Type: I ☒ II, III, IV, V, VI
System Description: Gravity, Conventional
Repair System Description: Gravity Conventional
Maintenance Agreement Required: ☐ Yes ☒ No

☒ House/Mod. Home No. Bedrooms 3
☐ Mobile Home No. Bathrooms 3
☐ Business No. Employees —
☐ Other —
☐ Slab ☒ Crawl Space ☐ Basement w/plumbing ☐ Basement wo/plumbing


Water Supply: ☐ Individual ☒ Public ☐ Community

Comments:/Conditions: ① Install lines on Contour ② maintain proper Setbacks


Comments:/Conditions: SEPTIC TANK WITH MARKER INSTALLED USING "TAPTITE" FITTER. SYSTEM LOCATION AS SHOWN.

(Not to Scale)

INITIAL SITE SKETCH

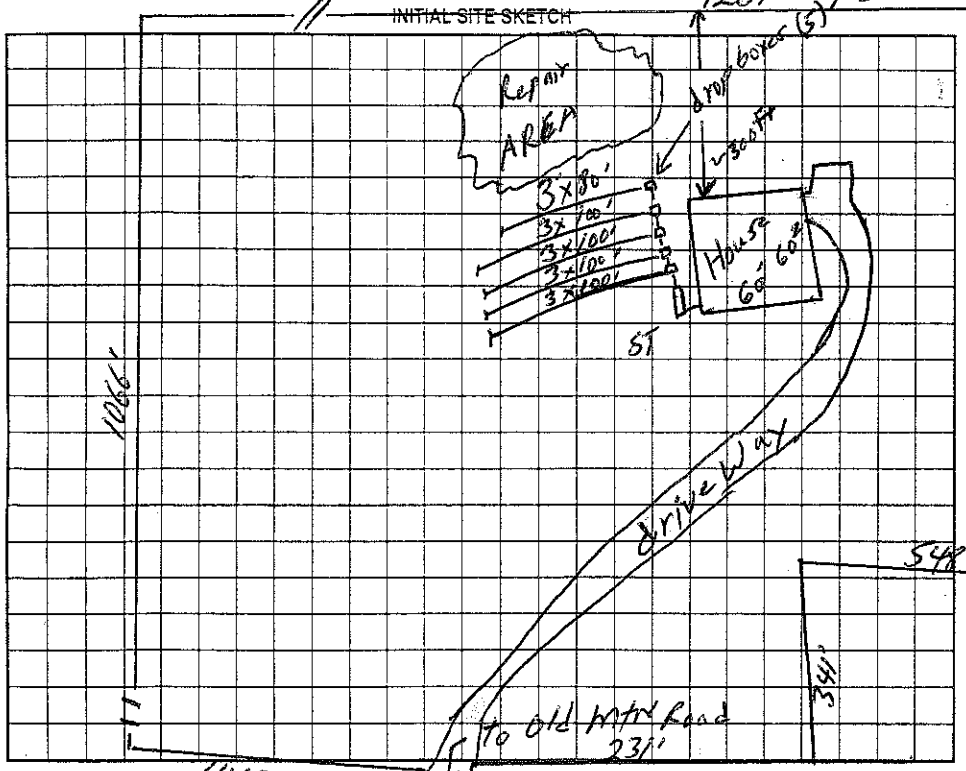

AS BUILT SKETCH

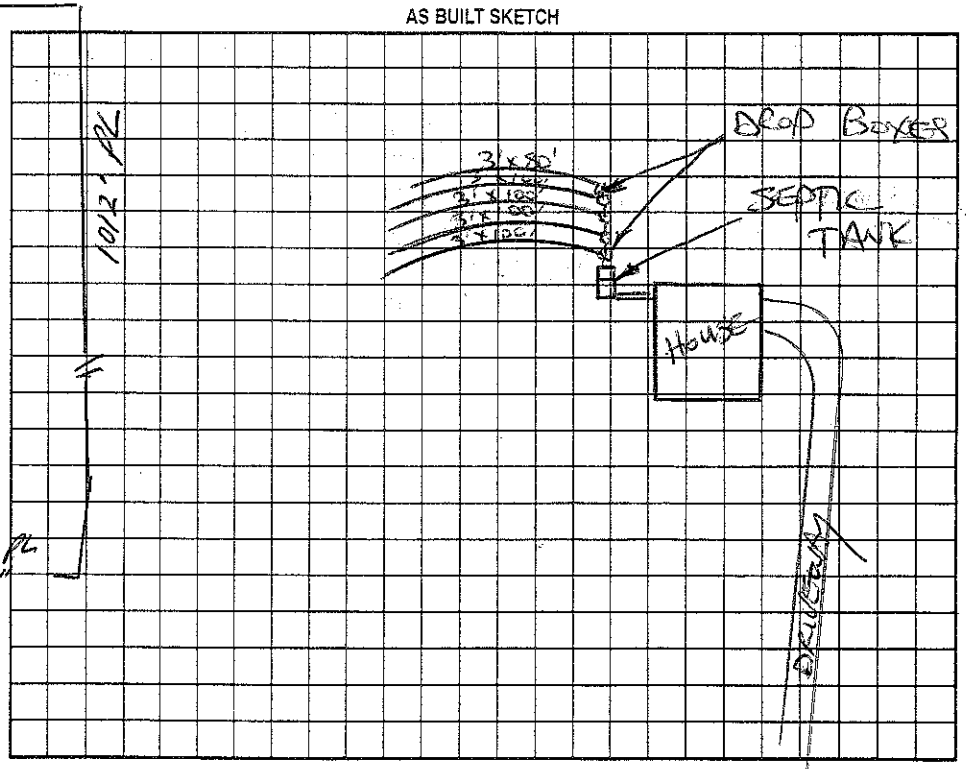

Permit can be suspended or revoked if any false information is supplied toward securing the permit/any unauthorized changes are made to the site/any unauthorized changes are made in the installation of the system. Improvement Permit with plat valid without expiration. Improvement Permit with site plan valid for sixty months. Authorization to Construct is valid for a period equal to that of Improvement Permit – not to exceed sixty months.

Signed: Thomas R Benfield Jr. date 11/12/03 Installed by: TOMMY FRYE

Improvement Permit by: William O. Johnson date 11/12/03 Operation Permit by: STEVE HENDRICK date 10-14-04

Authorization to Construct by: William O. Johnson date 11/12/03 Existing System Inspection by: — date —

HEALTH DEPT. COPY: WHITE OWNER COPY (FINAL): YELLOW OWNER COPY (INITIAL): PINK