IREDELL COUNTY HEALTH DEPARTMENT

Statesville Office (704) 878-5305 Mooresville Office (704) 660-3625 PERMIT # 202127

IMPROVEMENT PERMIT / AUTHORIZATION TO CONSTRUCT / OPERATION PERMIT / EXISTING SYSTEM

PIN # 4705227991

APPLICANT: Michisha Campbell APPLICANT ADDRESS: 173 Horseshoe lp Statesville NC 28625

SITE ADDRESS: 173 Horseshoe lp Statesville NC 28625 PHONE: 704-380-2752 ALT. PHONE: N/A

SITE DIRECTIONS: Old mtn Rd T/R Massey Dead T/R Horseshoe lp home on right

SUBDIVISION: O M Perry SECTION: N/A LOT # 41 LOT AREA: DESIGN FLOW: 360 L.T.A.R.: EX


Septic Tank	EX	(gal)	STB	EX	Date	EX	☐ New System	☐ Repair	☐ Expansion	System Type: I II (III) IV V VI	
Pump Tank	N/A	(gal)	PT	N/A	Date	N/A	System Description:				
Pump Make	N/A	Model	N/A		Serial #	N/A	Repair System Description:				
# Nitrification Fields	EX	# Lines	EX		Linear Ft:	EX	Maintenance Agreement Required:	☐ YES	☒ NO		
Trench Width	EX	Max. Trench Bottom Depth	EX		Gravel Depth	EX	☑ GRAVITY	☐ PRESSURE			

☒ Residence No. Bedrooms 3 — Water Supply
☐ Business No. Persons 6 — ☐ Private
☐ Other No. Employees — ☐ Public
☐ Slab ☒ Crawl Space — ☒ Community
☐ Basement w/plumbing ☐ Basement w/o plumbing

Comments / Conditions: All building foundations must be 5' from any part of STS.

INITIAL SITE SKETCH

AS BUILT SKETCH

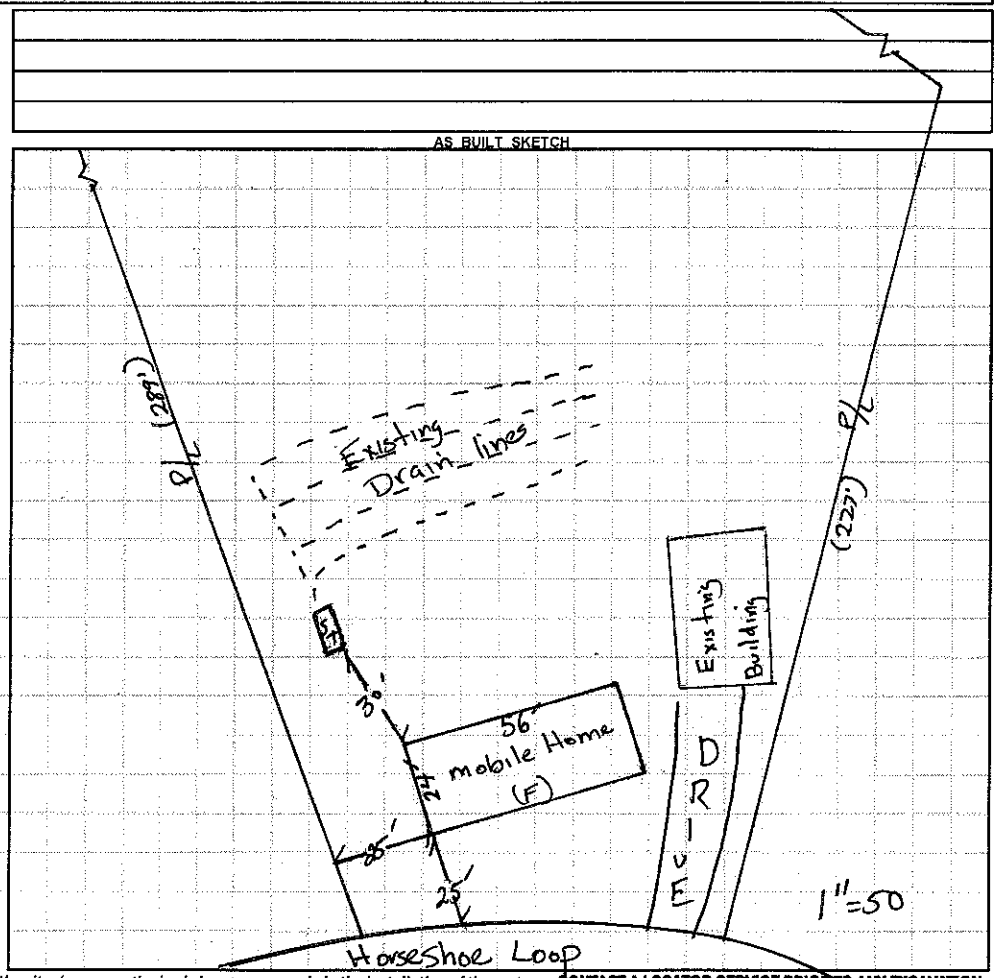

Permit can be suspended or revoked if any false information is supplied toward securing the permit / any unauthorized changes are made to the site / any unauthorized changes are made in the installation of the system. **CONTACT A LOCATOR SERVICE PRIOR TO ANY EXCAVATION**

☐ **IMPROVEMENT PERMIT** ***with plat*** *valid without expiration.* ☐ **IMPROVEMENT PERMIT** ***with site plan*** *valid for 60 mos.* ☐ **AUTHORIZATION TO CONSTRUCT** *valid for period equal to IMPROVEMENT PERMIT--not to exceed 60 mo.*

Owner / Applicant Signature: Michisha Campbell Date: Installed by:

IMPROVEMENT PERMIT by: Date: OPERATION PERMIT by: Date:

AUTHORIZATION TO CONSTRUCT by: Date: Existing System Inspected by: Robert H. Lowe Date: 03/17/14

Health Dept. Copy - WHITE Applicant (Final Approval) - YELLOW Applicant (Conditional Approval) - PINK