IREDELL COUNTY HEALTH DEPARTMENT

STATESVILLE 704-878-5305 MOORESVILLE 704-664-5281

IMPROVEMENT PERMIT / AUTHORIZATION TO CONSTRUCT / OPERATION PERMIT / EXISTING SYSTEM INSPECTION

PERMIT # Repair PIN # 4705 22 9821 DATE 4-22-10

OWNER or APPLICANT J. Gregg Connolly PHONE: Business 704 872 7410 Home:

OWNER or APPLICANT ADDRESS 171 Horseshoe Loop

LOCATION / DIRECTIONS Hwy 64 towards Taylorsville, (L) on Lippard Farm, (R) on Massey Dew (L) on Horseshoe Loop. Property on (L)

SUBDIVISION Perry BLOCK / SECTION LOT # 142 LOT AREA 1.81 DESIGN FLOW 360 L.T.A.R. Ex

Septic Tank 1000 Gallons: STB 760 Date 3-22-09

Pump Tank Gallons: P T Date

Pump Make Model Serial #

Nitrification Field No Fields Ex No Lines Ex Linear Feet Ex

Trench Width Ex Max. Trench Bottom Depth Ex Gravel Depth Ex ☒ GRAVITY ☐ PRESSURE

☐ New System ☑ Repair ☐ Expansion System Type (II) III IV V VI

System Description: Tank Replacement

Repair System Description:

Maintenance Agreement Required ☐ YES ☑ NO

☑ Residence No. Bedrooms 3

☐ Business No. Persons

☐ Other No. Employees

☐ Slab ☑ Crawl Space


☐ Basement w/plumbing ☐ Basement w/o plumbing

Water Supply: ☐ Private ☑ Public ☐ Community


Comments / Conditions

Comments / Conditions

INITIAL SITE SKETCH

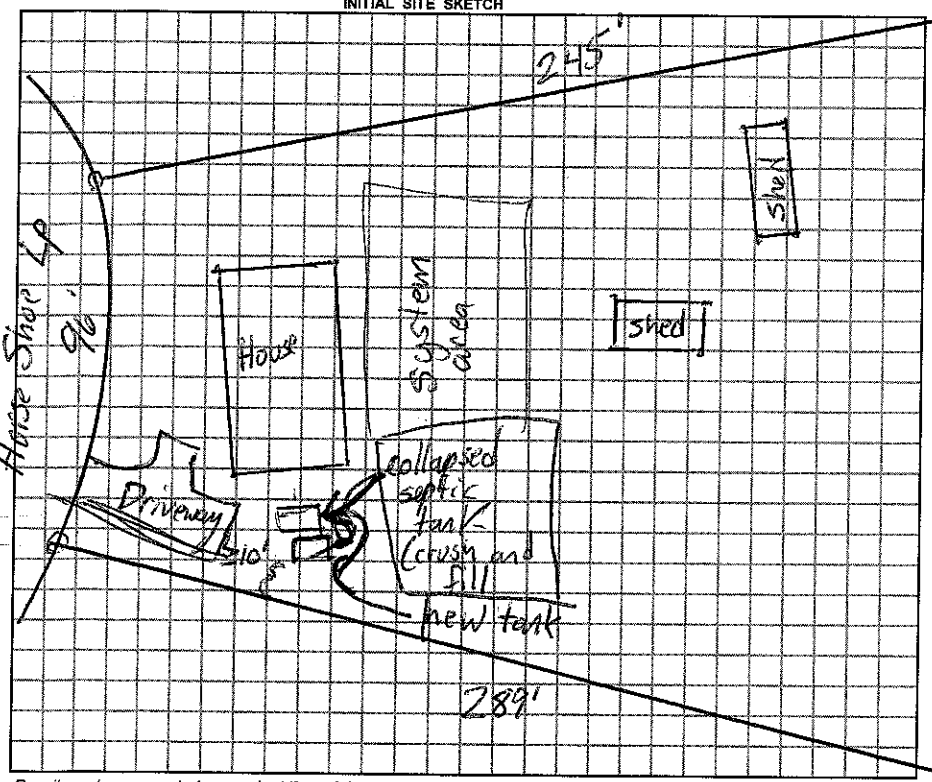

AS BUILT SKETCH

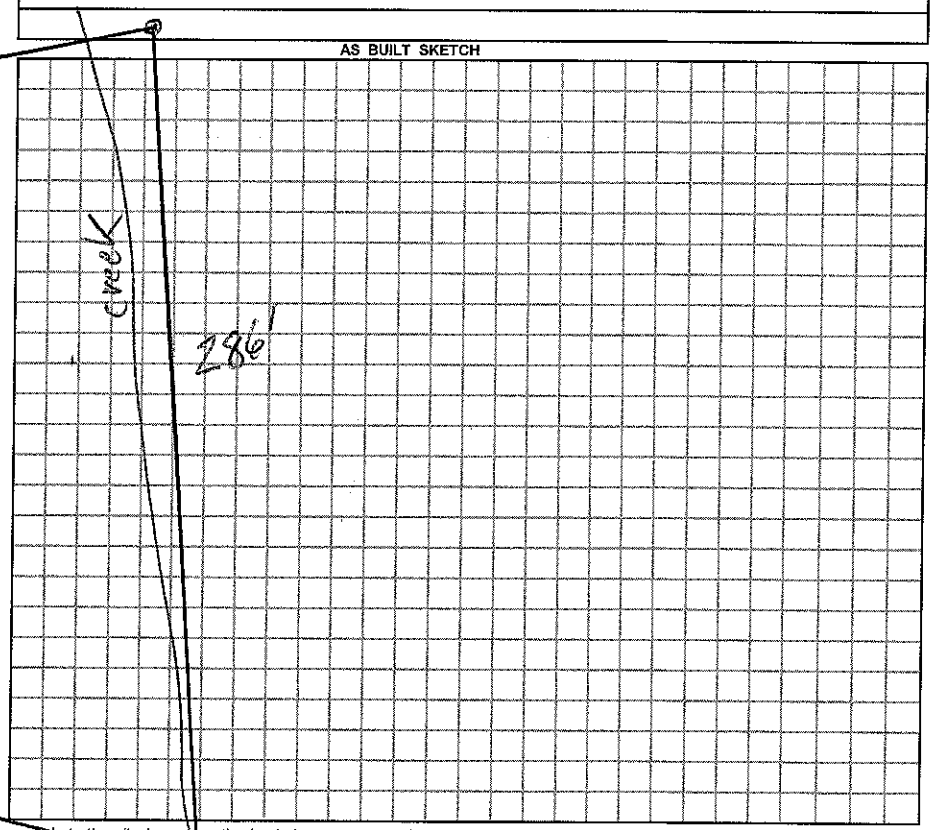

Permit can be suspended or revoked if any false information is supplied toward securing the permit / any unauthorized changes are made to the site / any unauthorized changes are made in the installation of the system.

☐ *IMPROVEMENT PERMIT w / plat valid without expiration.* ☐ *IMPROVEMENT PERMIT w / site plan valid for 60 mos.* ☑ *AUTHORIZATION TO CONSTRUCT valid for period equal to IMPROVEMENT PERMIT-not to exceed 60 mo.*

Owner / Applicant Signature: J Gregg Connolly Date 4-23-10

Improvement Permit by: Date

Authorization to Construct by: Date 4-22-10

Installed by: Leo's

Operation Permit by: Date: 4-30-10

Existing System Inspected by: Date:

YOU SHOULD CONTACT A LOCATOR SERVICE PRIOR TO ANY EXCAVATION.

WHITE COPY Environmental Health YELLOW COPY (Final) Owner / Applicant PINK COPY (Initial) Owner / Applicant