IREDELL COUNTY HEALTH DEPARTMENT

Statesville Phone TR 3-7271 Mooresville Phone NO 3-1271

PERMIT TO INSTALL SEPTIC TANK

Permit No. 44 Permit Date 5-10 1972

Owner Bobby Combs Address Stony Point N.C.

Installed By Harlan Lackey Address Stoney Point N.C.


Location of Property Old Mountain Road East Bradfords X Roads
T.R. on Rd #1520 - T.R. on Road #1652 - 4th House on R.
Old Neil Summers Place

Tank		Capacity		Length of Lines		Fixtures	
Block	( )	1000	(✓)	225'	(✓)	No. of Baths	(1½)
Precast	(✓)	1250	( )	250'	( )	Dishwasher	( )
		1500	( )	Other		Garbage Grdr.	( )
		Other				Other	

NOTIFY HEALTH DEPARTMENT AT LEAST EIGHT HOURS BEFORE TANK IS TO BE INSPECTED.

Final Inspection 5-10 1972 Approved (✓) Disapproved ( )

Remarks Community Water Supply

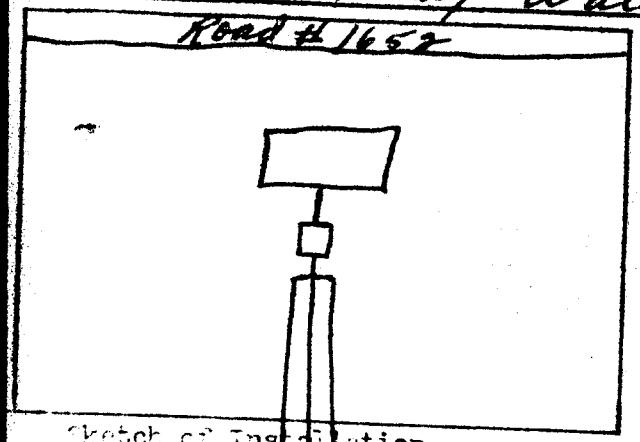

Sketch of Installation

E. A. Stevenson
Sanitarian