IREDELL COUNTY HEALTH DEPARTMENT - ENVIRONMENTAL HEALTH ☐ STATESVILLE OFFICE 704-878-5305 ☐ MOORESVILLE OFFICE 704-664-5281

IMPROVEMENT PERMIT / AUTHORIZATION TO CONSTRUCT / OPERATION PERMIT / EXISTING SYSTEM INSPECTION

PERMIT # Repair PIN # 4705-23-9563 DATE 3 May 2011

OWNER Heather Bartlett APPLICANT:

SITE ADDRESS 132 Robinette Lane. Stat. OWNER / APPLICANT ADDRESS PHONE: Home/Cell # (704) 883-6192 Business #

SITE DIRECTIONS old Mtn. Rd. TR Massey Deal TR Horseshoe Lp. Corner of Robinette and Horseshoe

SUBDIVISION O.M. Perry BLOCK / SECTION LOT # 61 LOT AREA 0.45 Ac. DESIGN FLOW 360gpd

Septic Tank 1000 Gallons: STB 107 Date 6-9-10 ☐ New System ☐ Repair ☐ Expansion System Type I (II) III IV V VI L.T.A.R. exist.

Pump Tank Gallons: PT Date System Description: Gravel bed conventional

Pump Make Model Serial # Repair System Description:

No. Nitrification Fields exist No. Lines exist Linear Feet exist Maintenance Agreement Required ☐ YES ☑ NO


Trench Width exist. Max. Trench Bottom Depth exist Gravel Depth exist ☑ GRAVITY ☐ PRESSURE

☑ Residence No. Bedrooms 3 ☐ Business No. Persons ☐ Other No. Employees ☐ Slab ☑ Crawl Space ☐ Basement w/plumbing ☐ Basement w/o plumbing

Water Supply: ☐ Private ☑ Public ☐ Community

Comments / Conditions # Replace existing septic tank with New 1000 gal ST / Properly abandon old septic tank.

INITIAL SITE SKETCH

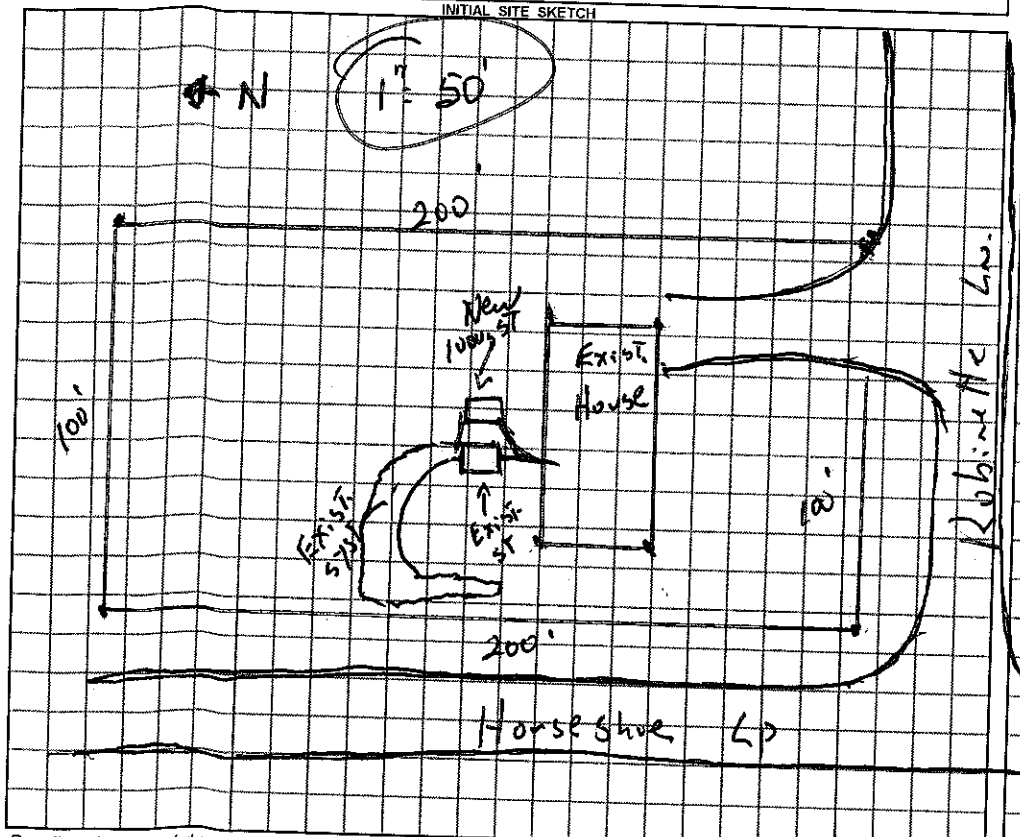

AS BUILT SKETCH

Permit can be suspended or revoked if any false information is supplied toward securing the permit / any unauthorized changes are made to the site / any unauthorized changes are made in the installation of the system.

☐ *IMPROVEMENT PERMIT* with plat valid without expiration. ☐ *IMPROVEMENT PERMIT* with ~~plat valid without expiration.~~ site plan valid 60 mo. ☐ *AUTHORIZATION TO CONSTRUCT* valid for period equal to IMPROVEMENT PERMIT--not to exceed 60 mo.

Owner / Applicant Signature: Heather Bartlett Date 5/31/11 Installed by: Derrick Barnes

IMPROVEMENT PERMIT by: REHS Date

AUTHORIZATION TO CONSTRUCT by: REHS Date 3 May 2011 OPERATION PERMIT by: REHS Date 6-21-11

YOU SHOULD CONTACT A LOCATOR SERVICE PRIOR TO ANY EXCAVATION Existing System Inspected by: REHS Date

White Copy -- Environmental Health YELLOW COPY (Final) Owner / Applicant PINK COPY (Initial) Owner / Applicant