IREDELL COUNTY HEALTH DEPARTMENT - *ENVIRONMENTAL HEALTH* ☐ STATESVILLE OFFICE 704-878-5305 ☐ MOORESVILLE OFFICE 704-664-5281

IMPROVEMENT PERMIT / AUTHORIZATION TO CONSTRUCT / OPERATION PERMIT / EXISTING SYSTEM INSPECTION

PERMIT # Repair PIN # 4705-23-9563 DATE 3 May 2011

OWNER Heather Bartlett APPLICANT: PHONE: Home/Cell # (704) 883-6192 Business #

SITE ADDRESS 132 Robinette Lane. Stat. OWNER / APPLICANT ADDRESS

SITE DIRECTIONS 0W Mtn. Rd. TR Massey Dead TR Horseshoe Lp. Corner of Robinette and Horseshoe

SUBDIVISION O.M. Perry BLOCK / SECTION LOT # 61 LOT AREA 0.45 ac. DESIGN FLOW 360 g/d L.T.A.R. exist.

Septic Tank 1000 Gallons: STB 107 Date 6-9-10 ☐ New System ☐ Repair ☐ Expansion System Type I (II) III IV V VI ☑ Residence No. Bedrooms 3 Water Supply

Pump Tank ____ Gallons: P T ____ Date ____ System Description: Gravel bed conventional ☐ Business No. Persons ____ ☐ Private


Pump Make ____ Model ____ Serial # ____ Repair System Description: ☐ Other No. Employees ____ ☑ Public

No. Nitrification Fields exist No. Lines exist Linear Feet exist Maintenance Agreement Required ☐ YES ☑ NO ☐ Slab ☑ Crawl Space ☐ Community

Trench Width exist. Max. Trench Bottom Depth exist Gravel Depth exist ☑ GRAVITY ☐ PRESSURE ☐ Basement w/plumbing ☐ Basement w/o plumbing

Comments / Conditions * Replace existing septic tank with new 1000g ST / Property abandon old septic tank.

INITIAL SITE SKETCH

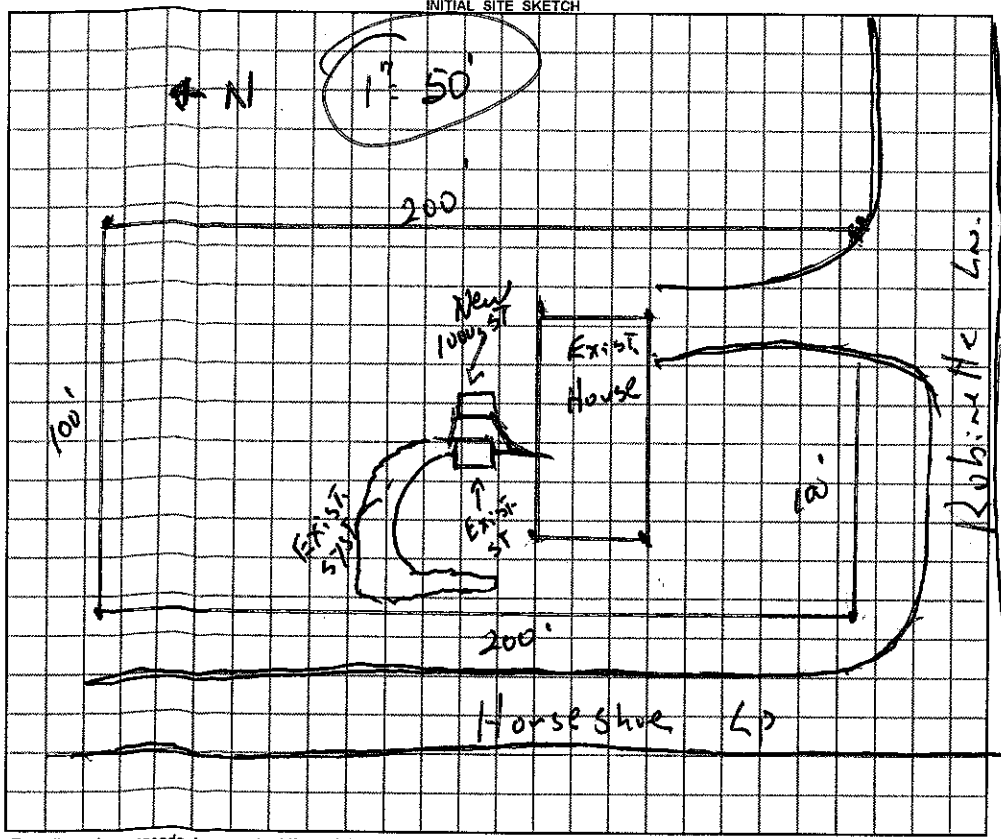

AS BUILT SKETCH

Permit can be suspended or revoked if any false information is supplied toward securing the permit / any unauthorized changes are made to the site / any unauthorized changes are made in the installation of the system.

☐ *IMPROVEMENT PERMIT* with plat valid without expiration. ☐ *IMPROVEMENT PERMIT* with ~~plat valid without expiration~~ site plan valid 60 mo. ☐ *AUTHORIZATION TO CONSTRUCT* valid for period equal to IMPROVEMENT PERMIT--not to exceed 60 mo.

Owner / Applicant Signature: Heather Bartlett Date 5/31/11 Installed by: Derrick Barnes

IMPROVEMENT PERMIT by: ____ REHS Date ____ OPERATION PERMIT by: ____ REHS Date 6-21-11

AUTHORIZATION TO CONSTRUCT by: ____ REHS Date 3 May 2011 Existing System Inspected by: ____ REHS Date ____

YOU SHOULD CONTACT A LOCATOR SERVICE PRIOR TO ANY EXCAVATION

White Copy – Environmental Health YELLOW COPY (Final) Owner / Applicant PINK COPY (Initial) Owner / Applicant