6158

IREDELL COUNTY HEALTH DEPARTMENT

STATESVILLE 704-878-5305 MOORESVILLE 704-664-5281

IMPROVEMENT PERMIT / CERTIFICATE OF COMPLETION / OPERATION PERMIT / EXISTING SYSTEM INSPECTION

Watershed: ☐ Yes ☑ No

PROPERTY DESCRIPTION NO. 23610 DATE 4-30-96 TAX MAP NO. 8T-4-A-1

OWNER OR CONTRACTOR CRAWFORD & O'BRIEN CONSTRUCTION PHONE: Business 871-1536 Home

ADDRESS 310 TREEBARK ROAD STATESVILLE NC 28677

LOCATION I-40 W TO OLD MOUNTAIN ROAD TR MASSEY DEAL ON LEFT PAST HORSESHOE LOOP

SUBDIVISION FLINT RIDGE BLOCK / SECTION LOT 1 LOT AREA N150X250' SITE CLASS. PS DESIGN FLOW 360 L.T.A.R. 0.30 GPD/FT²

Septic Tank: 1000 Gallons; STB 794 Date 4-6-96

Pump Tank: Gallons; PT Date

Pump Make: Model Serial No.

Nitrification Field: No Fields 1 Square Feet 1200 Linear Feet 400

No Lines 5 Trench Width 36 Max Trench Bottom Depth K-36

☑ New System ☐ Repair System Type: I, II, III, IV, V, VI

System Description: CONVENTIONAL GRAVITY

Repair System Description: CONV. GRAVITY

Maintenance Agreement Required: ☐ Yes ☐ No

☑ House/Mod. Home ☐ Mobile Home ☐ Business ☐ Other

No. Bedrooms 3 No. Bathrooms 2 No. Employees


☐ Slab ☑ Crawl Space ☐ Basement w/plumbing ☐ Basement wo/plumbing

Water Supply: ☐ Individual ☐ Community ☑ Public

Comments:

Comments:

INITIAL SITE SKETCH

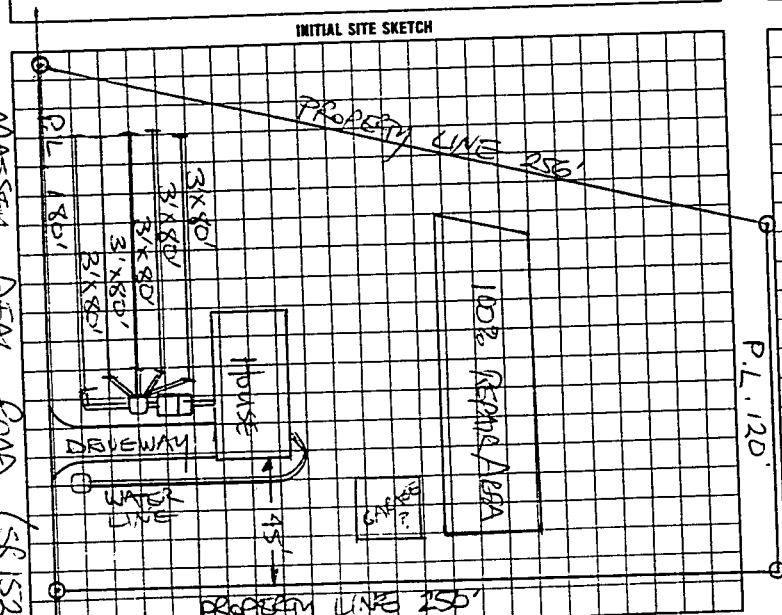

AS BUILT SKETCH

SYSTEM INSTALLED ACCORDING TO INITIAL SITE SKETCH

I understand that this permit can be suspended or revoked if any false information is supplied toward securing the permit/any unauthorized changes are made to the site/any unauthorized changes are made in the installation of the system. Authorization to Construct is valid five (5) years from date of issuance. Improvement Permit has no expiration date.

Signed:

Improvement Permit by: STEVE HEDRICK date 4-30-96

Installed by: A-1 BACKHOE date

Certificate of Completion by: STEVE HEDRICK date 6-26-96

Operation Permit by: STEVE HEDRICK date 4-30-96

AUTHORIZATION TO CONSTRUCT: HEALTH DEPT. COPY WHITE INSPECTION COPY (FINAL) GREEN OWNER COPY (FINAL) YELLOW INSPECTION COPY (INITIAL) PINK OWNER COPY (INITIAL) GOLD

5 5 0 3 0 0