IREDELL COUNTY HEALTH DEPARTMENT - *ENVIRONMENTAL HEALTH* ☑ STATESVILLE OFFICE 704-878-5305 ☐ MOORESVILLE OFFICE 704-664-5281

IMPROVEMENT PERMIT / AUTHORIZATION TO CONSTRUCT / OPERATION PERMIT / EXISTING SYSTEM INSPECTION

PERMIT # 171633 PIN # 4705-24-3244 DATE APRIL 16, 2012

OWNER WILSON BUILDING CO, APPLICANT: SAME PHONE: Home/Cell # 704-880-8219 Business # 704-881-0071

SITE ADDRESS 287 MASSEY DEAR RD, OWNER / APPLICANT ADDRESS 120 WHITE DOGWOOD LANE STVL NC 28625

SITE DIRECTIONS I-40 W, TR OLD MOUNTAIN ROAD, TR MASSEY DEAR RD ON LEFT AT BOX # 287.

SUBDIVISION PONDEROSA FARMS BLOCK / SECTION LOT # 3 LOT AREA 1.01 ACRE DESIGN FLOW 360 L.T.A.R. 0.25 GPD/FT²

Septic Tank 1000 Gallons: STB 1017 Date 11-15-11
Pump Tank Gallons: P T Date
Pump Make Model Serial #
No. Nitrification Fields: 1 No. Lines 3 Linear Feet 480
Trench Width 36" Max. Trench Bottom Depth 36" Gravel Depth 12"


☑ New System ☐ Repair ☐ Expansion System Type I (II) III IV V VI
System Description: CONVENTIONAL GRAVITY
Repair System Description: CONVENTIONAL, PUMP
Maintenance Agreement Required ☐ YES ☒ NO
☑ GRAVITY ☐ PRESSURE

☑ Residence No. Bedrooms 3
☐ Business No. Persons
☐ Other No. Employees
☐ Slab ☑ Crawl Space
☐ Basement w/plumbing ☐ Basement w/o plumbing


Water Supply: ☐ Private ☑ Public ☐ Community

Comments / Conditions
(1) AN ACCEPTED SYSTEM MAY ALSO BE USED
(2) INSTALL SYSTEM ON CONTOUR AS FLAGGED ON SITE
(3) SCOUR TRENCH SIDEWALLS WHERE SMEARING OCCURS.
(4) USE SERIAL DISTRIBUTION

INITIAL SITE SKETCH

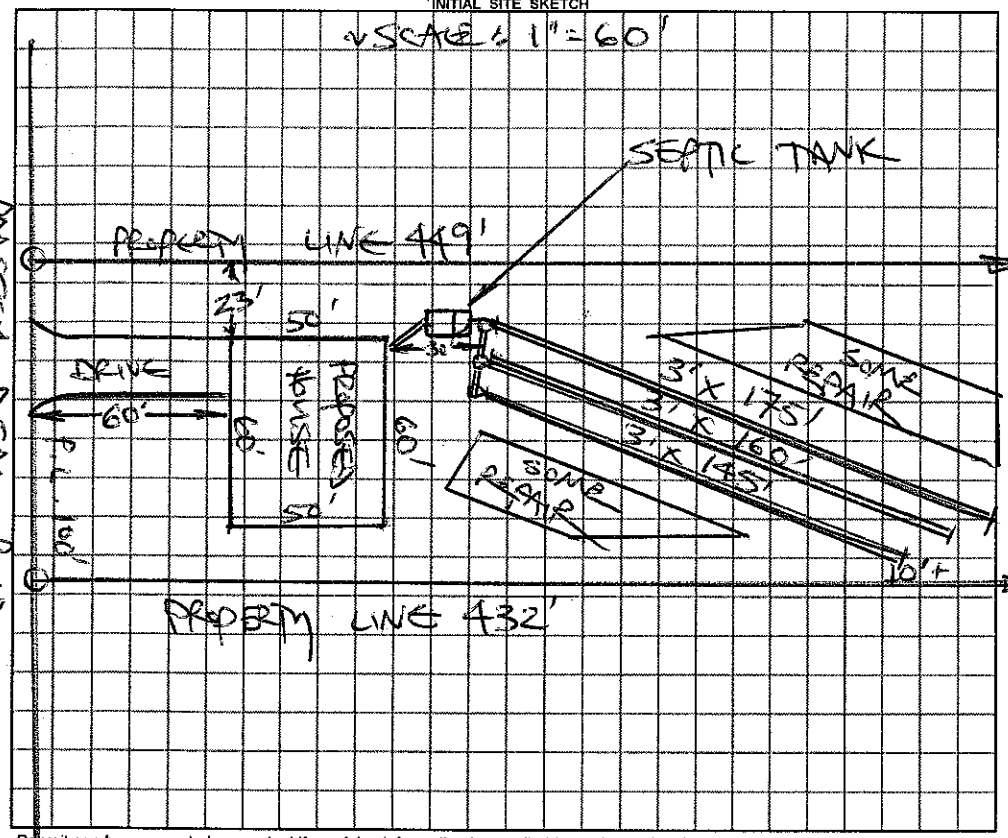

AS BUILT SKETCH

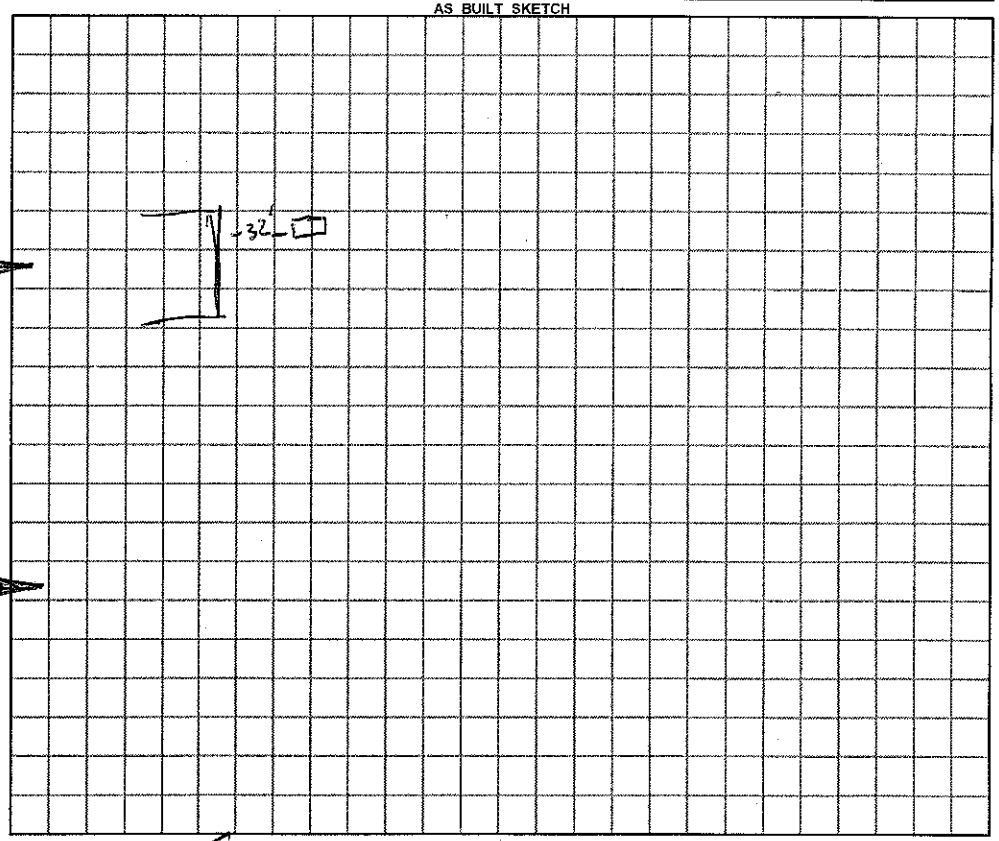

Permit can be suspended or revoked if any false information is supplied toward securing the permit / any unauthorized changes are made to the site / any unauthorized changes are made in the installation of the system.

☐ ***IMPROVEMENT PERMIT*** with plat valid without expiration. ☑ ***IMPROVEMENT PERMIT*** with plat valid without expiration. site plan valid 60 mo. ☑ ***AUTHORIZATION TO CONSTRUCT*** valid for period equal to IMPROVEMENT PERMIT--not to exceed 60 mo.

Owner / Applicant Signature: Ray Wilson Date 4-16-2012 Installed by: Piedmont Backhoe (Jordan)

IMPROVEMENT PERMIT by: STEVE HENDRICK REHS Date APRIL 16, 2012 OPERATION PERMIT by: REHS Date 7-31-12

AUTHORIZATION TO CONSTRUCT by: STEVE HENDRICK REHS Date APRIL 16, 2012 Existing System Inspected by: REHS Date

YOU SHOULD CONTACT A LOCATOR SERVICE PRIOR TO ANY EXCAVATION

White Copy – Environmental Health YELLOW COPY (Final) Owner / Applicant PINK COPY (Initial) Owner / Applicant