Jason Wood

205865

IREDELL COUNTY HEALTH DEPARTMENT

Statesville Office (704) 878-5305 Mooresville Office (704) 660-3625 PERMIT # 201189

IMPROVEMENT PERMIT / AUTHORIZATION TO CONSTRUCT / OPERATION PERMIT / EXISTING SYSTEM

PIN # 4705243244

APPLICANT: Wilson Building Co. APPLICANT ADDRESS: 120 White Dogwood Ln.

SITE ADDRESS: 287 Massey Deal Rd. PHONE: 704-880-8219 ALT. PHONE: N/A

SITE DIRECTIONS: I-40W to OH. Mtn Rd. TR old Mtn Rd. TR Massey Deal Rd.


SUBDIVISION: Ponderosa Farms SECTION: N/A LOT # 3 LOT AREA: 1.01 acres DESIGN FLOW: 360 gpd L.T.A.R.: 0.25

Septic Tank	Existing (gal)	STB		Date		New System	Repair	Expansion	System Type: I II III IV V VI
Pump Tank	(gal)	PT		Date		System Description:			
Pump Make		Model		Serial #		Repair System Description:	25% Reduction w/ French Drain		
# Nitrification Fields	1	# Lines	2	Linear Ft:	24	Maintenance Agreement Required:	YES	NO	
Trench Width	36"	Max. Trench Bottom Depth	36"	Gravel Depth	N/A		GRAVITY	PRESSURE	


Residence	No. Bedrooms	3	Water Supply: Private
Business	No. Persons	6	Public
Other	No. Employees		Community
Slab	Crawl Space		
Basement w/plumbing			Basement w/o plumbing

Comments / Conditions: Install a 25% Reduction system on contour with serial distribution. Extend existing nitrification lines as shown below. Install french drain on high side of nitrification field a minimum of 15' above drainfield, as close to Property line as possible, as shown below.

INITIAL SITE SKETCH

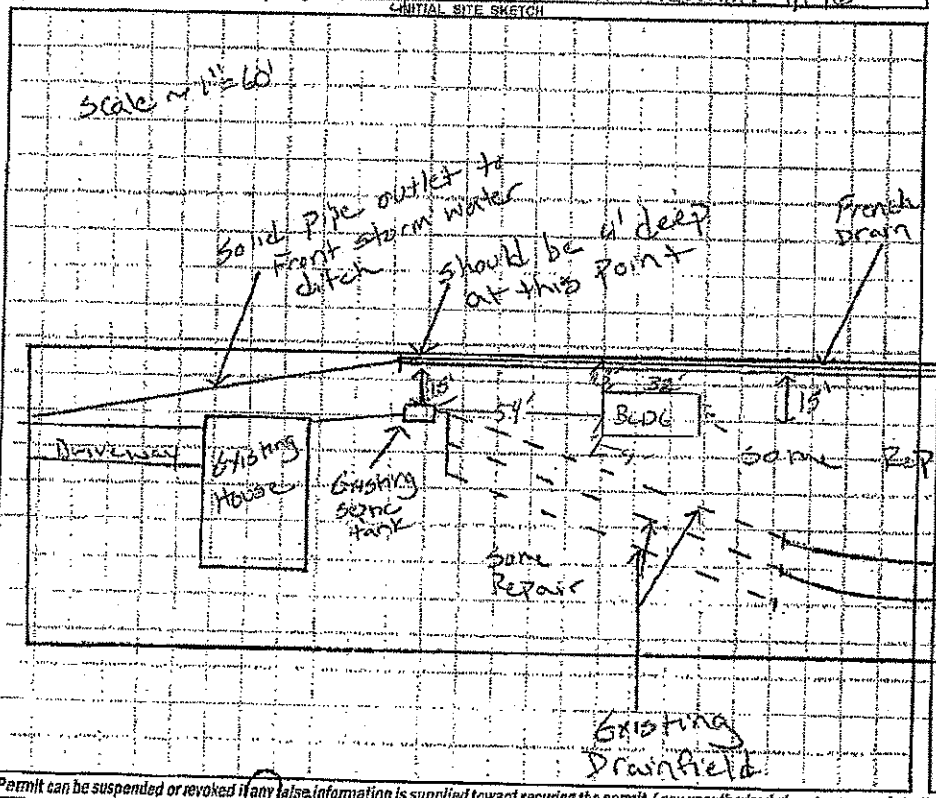

AS BUILT SKETCH

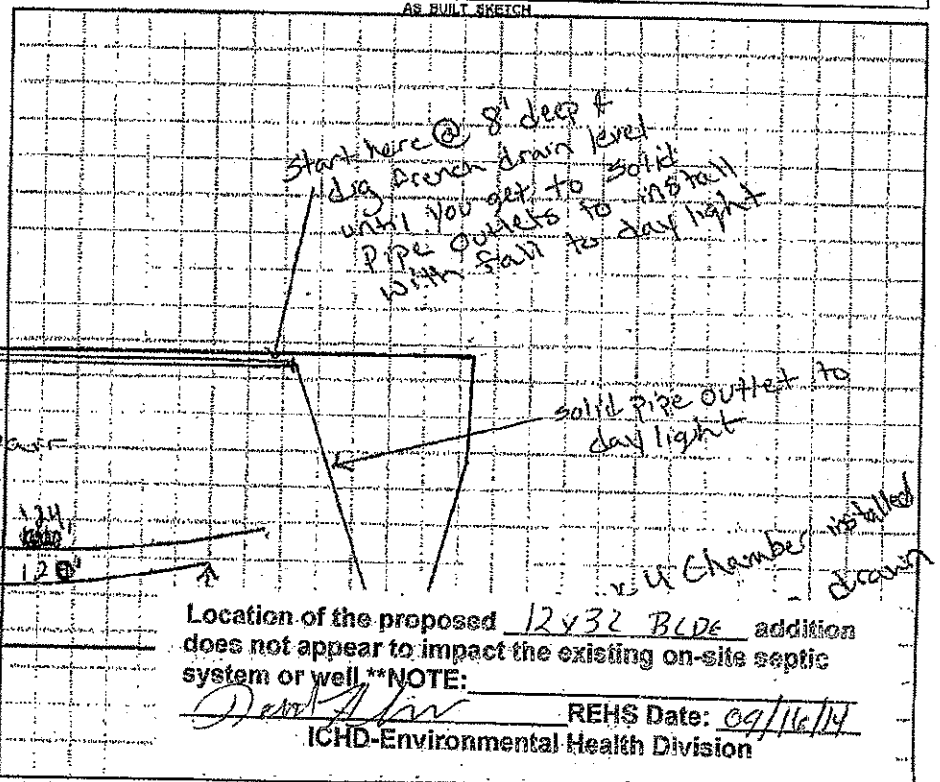

Location of the proposed 12x32 BLDG addition does not appear to impact the existing on-site septic system or well.**NOTE:

REHS Date: 09/16/14

ICHD-Environmental Health Division

Permit can be suspended or revoked if any false information is supplied toward securing the permit / any unauthorized changes are made to the site / any unauthorized changes are made in the installation of the system. CONTACT A LOCATOR SERVICE PRIOR TO ANY EXCAVATION

☐ IMPROVEMENT PERMIT with plat valid without expiration ☒ IMPROVEMENT PERMIT with site plan valid for 60 mos. ☒ AUTHORIZATION TO CONSTRUCT valid for period equal to IMPROVEMENT PERMIT--not to exceed 60 mo.

Owner / Applicant Signature: [signature] Date: 2-17-14 Installed by: Steve Durham

IMPROVEMENT PERMIT by: [signature] Date: 2-7-14 OPERATION PERMIT by: [signature] Date: 4-2-14

AUTHORIZATION TO CONSTRUCT by: [signature] Date: 2-7-14 Existing System Inspected by: Date:

Health Dept. Copy - WHITE Applicant (Final Approval) - YELLOW Applicant (Conditional Approval) - PINK