IREDELL COUNTY HEALTH DEPARTMENT


ENVIRONMENTAL HEALTH DIVISION

PAGE 2: *SITE PLAN WORKSHEET*

SEE THE "SAMPLE SITE PLAN" BELOW. *INCOMPLETE SITE PLANS WILL BE RETURNED TO YOU FOR COMPLETION AND MAY RESULT IN A DELAY IN THE ISSUANCE OF YOUR SEPTIC SYSTEM PERMIT!!!*

Place an (X) beside each item as you complete the site plan:

- (X) Property Line measurements are clearly identified
- (X) All *proposed structures* are indicated
- (X) Front and side setbacks from property line
- (X) Preferred driveway location and well location
- (X) Area you prefer your septic system to be placed
- (X) North arrow, or other sufficient indicator of direction

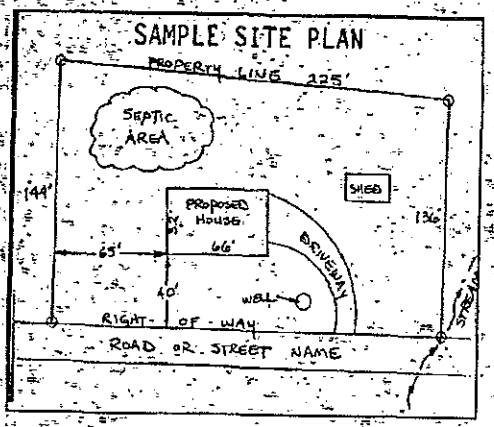


Circle N/A on the following if appropriate:

- Location of septic systems and wells within 100' of your property — N/A
- Location of easements and rights of ways on your property — N/A
- Location of any designated wetlands on the property — N/A

USE THIS SPACE TO DRAW YOUR SITE PLAN

Show: proposed house or business footprint, wells, water lines, patios, pools and decks, and any other item that will occupy space on the site

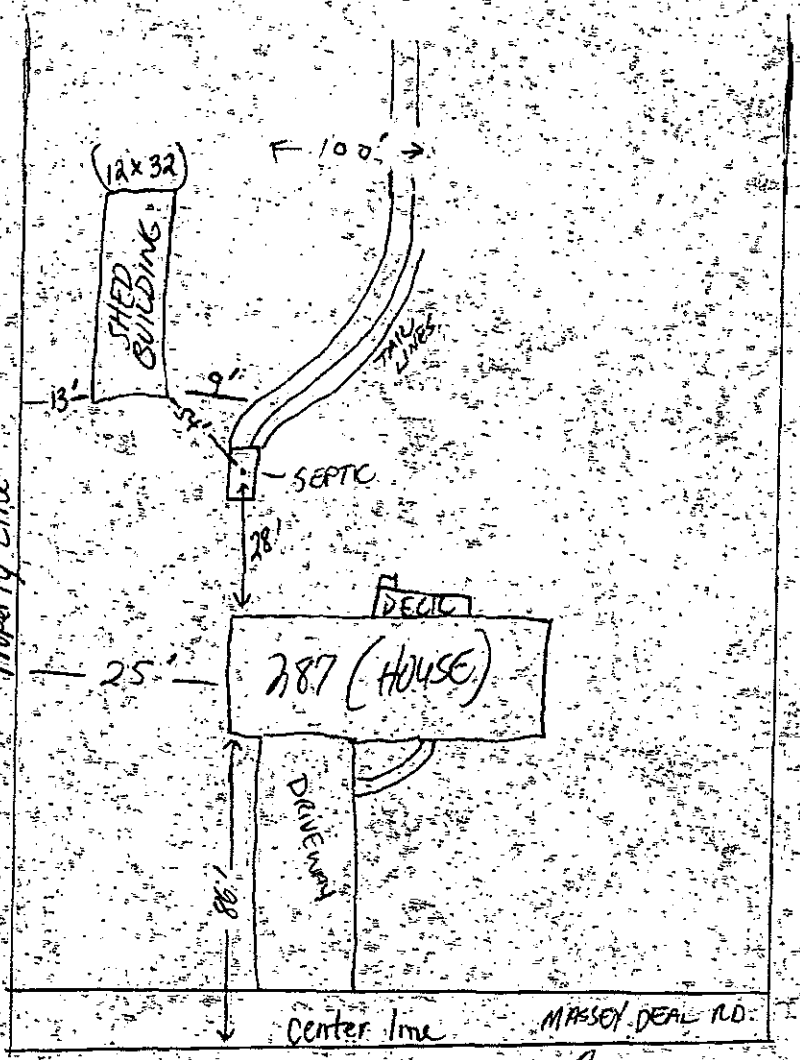

Signature: Joan O Wall
Property owner or owner's legal representative signature (SIGNATURE REQUIRED)

9/16/14
DATE

Jason Wood

205865

IREDELL COUNTY HEALTH DEPARTMENT

Statesville Office (704) 878-5305 Mooresville Office (704) 660-3625 PERMIT # 201189

IMPROVEMENT PERMIT / AUTHORIZATION TO CONSTRUCT / OPERATION PERMIT / EXISTING SYSTEM

PIN # 4705243244

APPLICANT: Wilson Building Co. APPLICANT ADDRESS: 120 White Dogwood Ln.

SITE ADDRESS: 2987 Massey Dead Rd. PHONE: 704-880-8219 ALT. PHONE: N/A

SITE DIRECTIONS: I-40W to Old Mtn Rd. TR old mtn Rd. TR Massey Dead Rd.

SUBDIVISION: Ponderosa Farms SECTION: N/A LOT # 3 LOT AREA: 1.01 acres DESIGN FLOW: 360 gpd L.T.A.R.: 0.25

Septic Tank 6x15 tmy (gal) STB Date
Pump Tank (gal) PT Date
Pump Make Model Serial #
Nitrification Fields 1 # Lines 2 Linear Ft: 240'
Trench Width 36" Max. Trench Bottom Depth 36" Gravel Depth N/A


☐ New System ☑ Repair ☐ Expansion System Type: I II III IV V VI
System Description:
Repair System Description: 25% Reduction w/ French Drain
Maintenance Agreement Required: ☐ YES ☑ NO
☑ GRAVITY ☐ PRESSURE

☑ Residence No. Bedrooms 3
☐ Business No. Persons 6
☐ Other No. Employees
☐ Slab ☑ Crawl Space
☐ Basement w/plumbing ☐ Basement w/o plumbing


Water Supply: ☐ Private ☑ Public ☐ Community

Comments / Conditions: Install a 25% Reduction system on contour with serial distribution. Extend existing nitrification lines as shown below. Install french drain on high side of nitrification field a minimum of 15' above drainfield, as close to Property line as possible, as shown below.

INITIAL SITE SKETCH

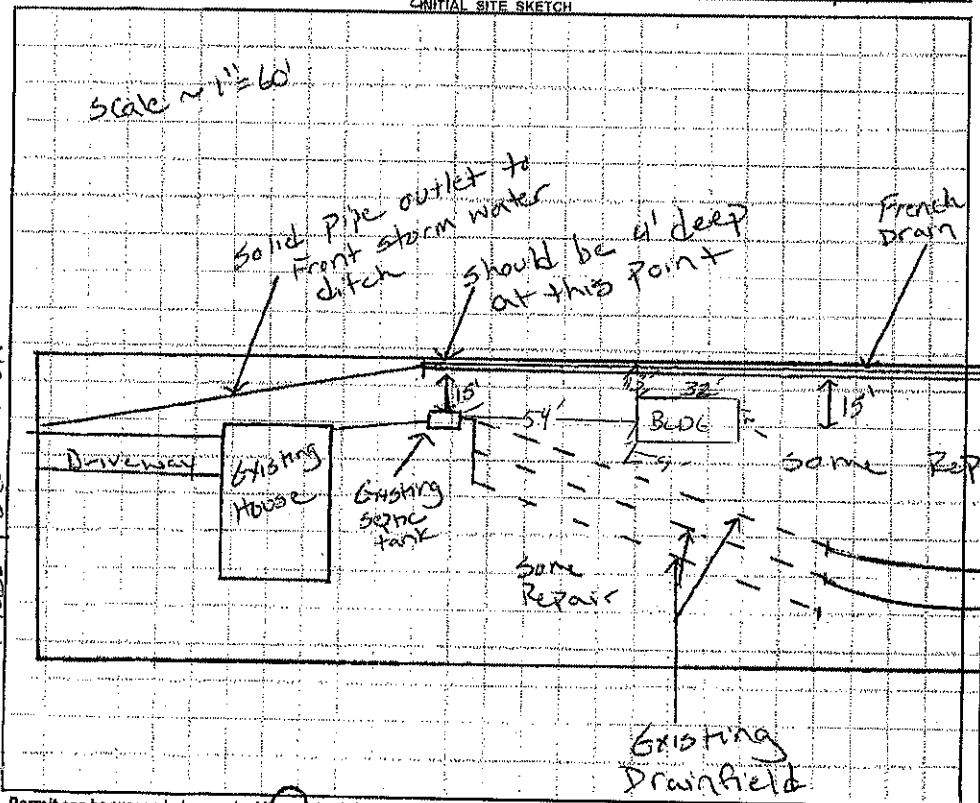

AS BUILT SKETCH

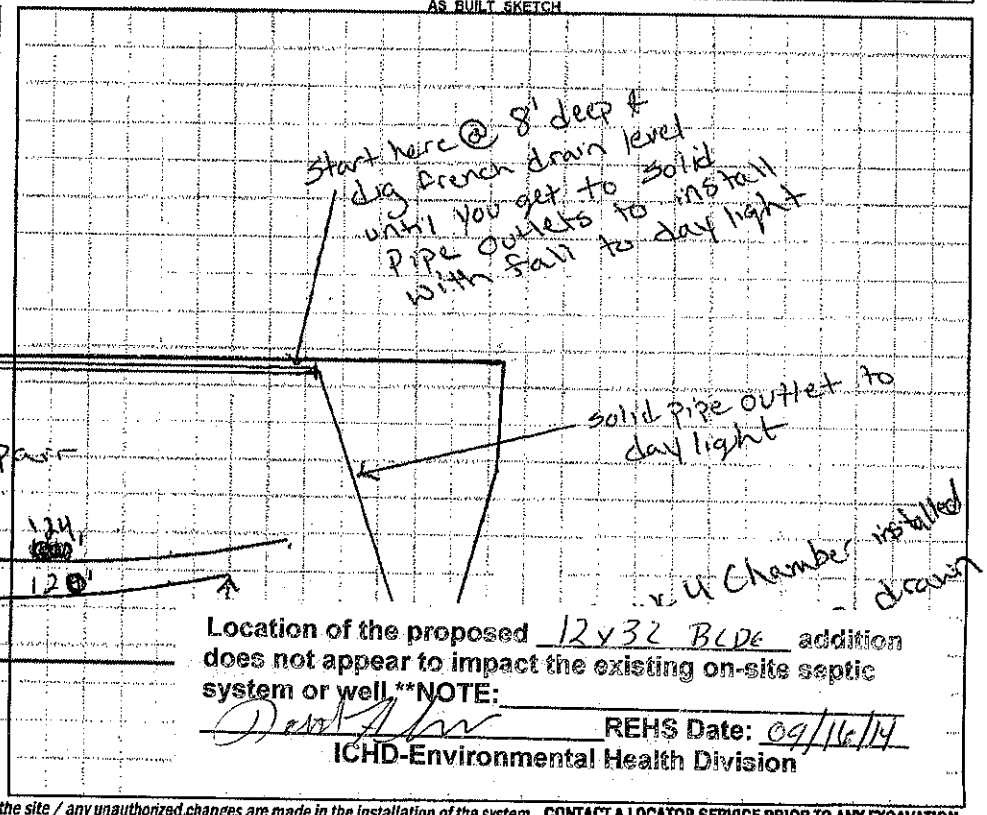

Location of the proposed 12x32 BLDG addition does not appear to impact the existing on-site septic system or well.**NOTE:

REHS Date: 09/16/14

ICHD-Environmental Health Division

Permit can be suspended or revoked if any false information is supplied toward securing the permit / any unauthorized changes are made to the site / any unauthorized changes are made in the installation of the system. **CONTACT A LOCATOR SERVICE PRIOR TO ANY EXCAVATION**

☐ **IMPROVEMENT PERMIT** *with plat valid without expiration* ☑ **IMPROVEMENT PERMIT** *with site plan valid for 60 mos.* ☑ **AUTHORIZATION TO CONSTRUCT** *valid for period equal to IMPROVEMENT PERMIT--not to exceed 60 mo.*

Owner / Applicant Signature: Date: 2-17-14 Installed by: Steve Jordan

IMPROVEMENT PERMIT by: Date: 2-7-14 OPERATION PERMIT by: Date: 4-2-14

AUTHORIZATION TO CONSTRUCT by: Date: 2-7-14 Existing System Inspected by: Date:

Health Dept. Copy - WHITE Applicant (Final Approval) - YELLOW Applicant (Conditional Approval) - PINK