**IREDELL COUNTY HEALTH DEPARTMENT - *ENVIRONMENTAL HEALTH*** ☑ STATESVILLE OFFICE 704-878-5305 ☐ MOORESVILLE OFFICE 704-664-5281

**IMPROVEMENT PERMIT / AUTHORIZATION TO CONSTRUCT / OPERATION PERMIT / EXISTING SYSTEM INSPECTION**

PERMIT # 165362 PIN # 4705-24-4251 DATE 10 March 11

OWNER Randy Wilson APPLICANT: Wilson Bldg., Inc. PHONE: Home/Cell # (704) 880-8259 Business #

SITE ADDRESS Massey Dean Rd. Styl 28625 OWNER / APPLICANT ADDRESS

SITE DIRECTIONS I40W - Turn on old NW Rd. TR Massey Dean Rd. Lt on 1st home Horseshoe Loop

SUBDIVISION Ponderosa Farms BLOCK / SECTION LOT # 4 LOT AREA 0.96ac. DESIGN FLOW 360gpd L.T.A.R. 0.3g/ft²/d

Septic Tank 1000g Gallons: STB 1012 Date 4-1-11 ☑ New System ☐ Repair ☐ Expansion System Type I II III IV V VI ☑ Residence No. Bedrooms 3 Water Supply ☐ Private ☑ Public ☐ Community

Pump Tank Gallons: PT Date System Description: 25% Reduction System ☐ Business No. Persons


Pump Make Model Serial # Repair System Description: 25% Reduction System ☐ Other No. Employees

No. Nitrification Fields: 1 No. Lines 3 Linear Feet 300 Maintenance Agreement Required ☐ YES ☑ NO ☐ Slab ☑ Crawl Space


Trench Width 36" Max. Trench Bottom Depth 36" Gravel Depth NA ☑ GRAVITY ☐ PRESSURE ☐ Basement w/plumbing ☐ Basement w/o plumbing

Comments / Conditions Follow Contour (Pot/lock t-th SI Marker

INITIAL SITE SKETCH

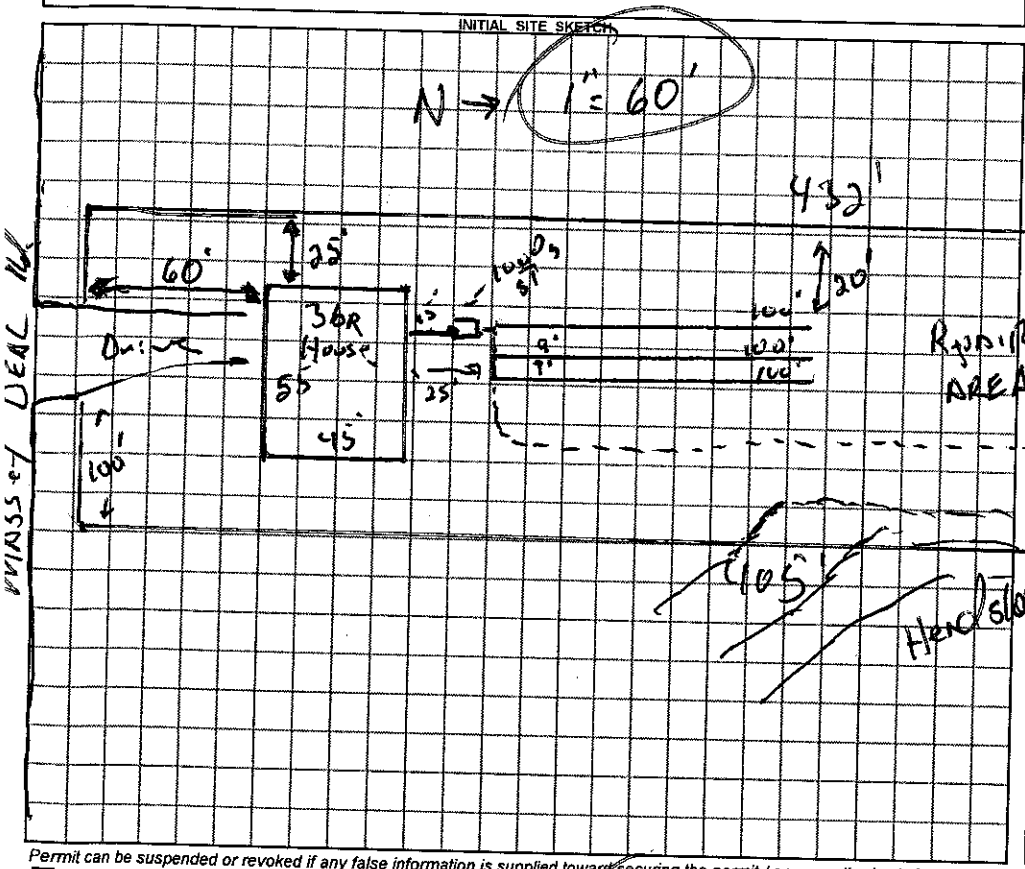


AS BUILT SKETCH

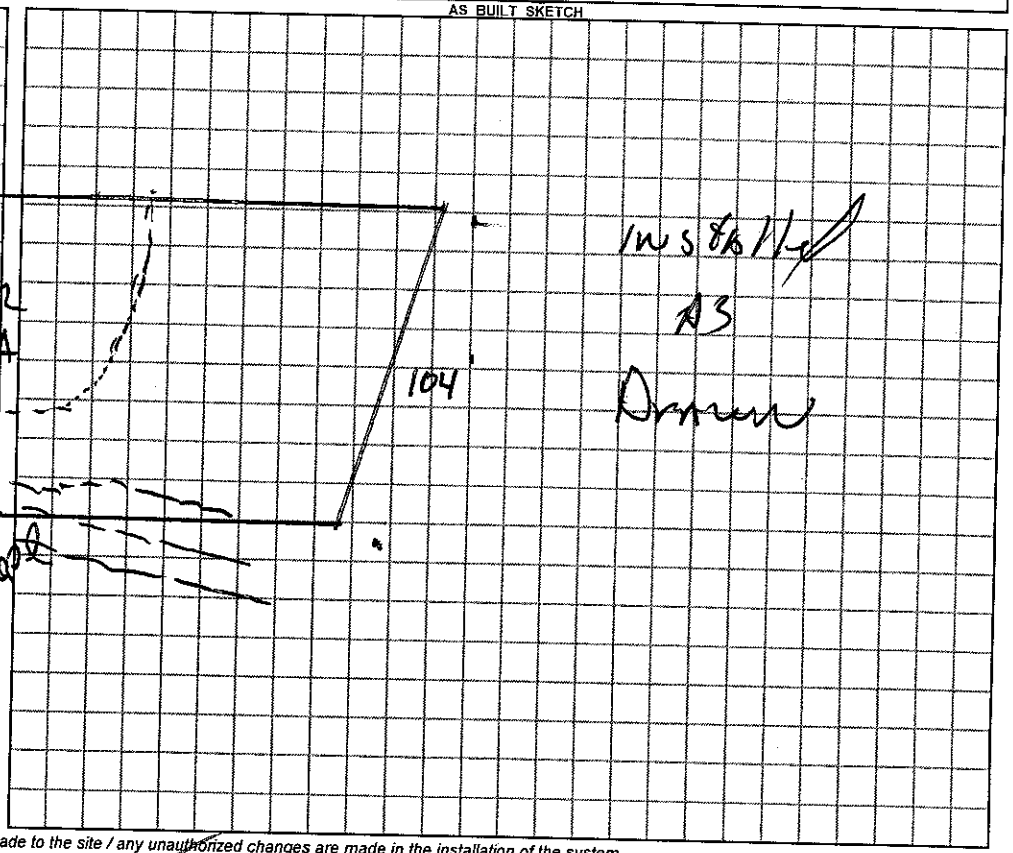


*Permit can be suspended or revoked if any false information is supplied toward securing the permit / any unauthorized changes are made to the site / any unauthorized changes are made in the installation of the system.*

☐ ***IMPROVEMENT PERMIT*** with plat valid without expiration. ☑ ***IMPROVEMENT PERMIT*** with plat valid without expiration. site plan valid 60 mo. ☑ ***AUTHORIZATION TO CONSTRUCT*** valid for period equal to IMPROVEMENT PERMIT–not to exceed 60 mo.

Owner / Applicant Signature: Date 3-15-2011 Installed by: Steve Jordan

IMPROVEMENT PERMIT by: REHS Date 10 March 11 OPERATION PERMIT by: REHS Date 1-3-2012

AUTHORIZATION TO CONSTRUCT by: REHS Date 10 March 11 Existing System Inspected by: REHS Date

***YOU SHOULD CONTACT A LOCATOR SERVICE PRIOR TO ANY EXCAVATION***

White Copy – Environmental Health YELLOW COPY (Final) Owner / Applicant PINK COPY (Initial) Owner / Applicant