IREDELL COUNTY HEALTH DEPARTMENT

Statesville Office (704) 878-5305 Mooresville Office (704) 660-3625 PERMIT # 17957/

IMPROVEMENT PERMIT / AUTHORIZATION TO CONSTRUCT / OPERATION PERMIT / EXISTING SYSTEM

PIN # 4705246138

APPLICANT: Wilson Building Inc APPLICANT ADDRESS: 120 White Dogwood Ln.

SITE ADDRESS: 303 Massey Dean Rd. PHONE: 704-880-8219 ALT. PHONE: N/A

SITE DIRECTIONS: I-40 W to Old Mtn Rd. TR on Old Mtn Rd TR Massey Dean Rd.

SUBDIVISION: Ponderosa Farms SECTION: N/A LOT # 6 LOT AREA: 0.83 acres DESIGN FLOW: 360 gpd L.T.A.R.: 0.25

Septic Tank 1000 (gal) STB # 1012 - 1000 Date 9-14-13
Pump Tank (gal) PT Date
Pump Make Model Serial #
Nitrification Fields 1 # Lines 4 Linear Ft: 360
Trench Width 36" Max. Trench Bottom Depth 36" Gravel Depth N/A


☑ New System ☐ Repair ☐ Expansion System Type: I II ☑ III IV V VI
System Description: 25% Reduction
Repair System Description: 25% Reduction - Pump
Maintenance Agreement Required: ☐ YES ☑ NO
☐ GRAVITY ☐ PRESSURE

☑ Residence No. Bedrooms 3
☐ Business No. Persons
☐ Other No. Employees
☐ Slab ☑ Crawl Space
☐ Basement w/plumbing ☐ Basement w/o plumbing

Water Supply
☐ Private
☑ Public
☐ Community

Comments / Conditions: Install a 25% Reduction System on Contour with Serial distribution.

INITIAL SITE SKETCH

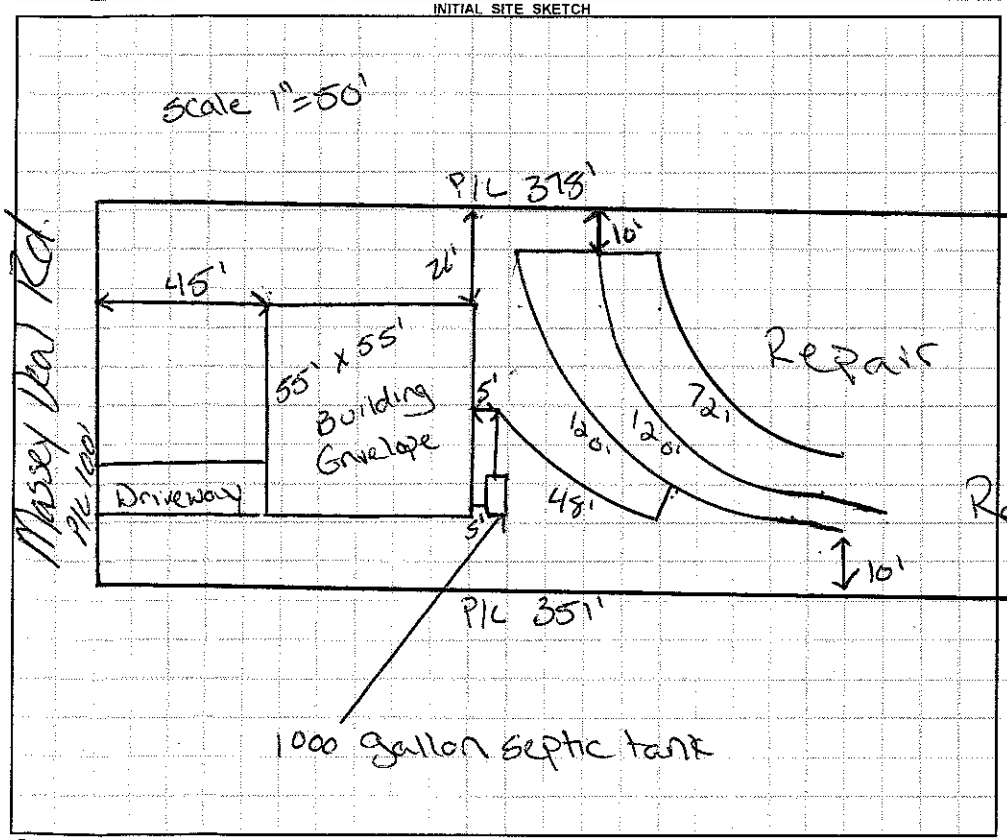

AS BUILT SKETCH

- 21" PVC Tank markers installed
- Red Polylock Sites installed
- Quick 4 Chambers installed as drawn

Permit can be suspended or revoked if any false information is supplied toward securing the permit / any unauthorized changes are made to the site / any unauthorized changes are made in the installation of the system. **CONTACT A LOCATOR SERVICE PRIOR TO ANY EXCAVATION**

☐ **IMPROVEMENT PERMIT** *with plat valid without expiration.* ☑ **IMPROVEMENT PERMIT** *with site plan valid for 60 mos.* ☑ **AUTHORIZATION TO CONSTRUCT** *valid for period equal to IMPROVEMENT PERMIT--not to exceed 60 mo.*

Owner / Applicant Signature: Date: 10-4-13 Installed by: Steve Jordan

IMPROVEMENT PERMIT by: Justin Henderson Date: 7-23-13 OPERATION PERMIT by: Justin Henderson Date: 1-21-14

AUTHORIZATION TO CONSTRUCT by: Justin Henderson Date: 7-23-13 Existing System Inspected by: Date:

Health Dept. Copy - WHITE Applicant (Final Approval) - YELLOW Applicant (Conditional Approval) - PINK