2:00

# IREDELL COUNTY HEALTH DEPARTMENT

STATESVILLE 704-878-5305 (2) MOORESVILLE 704-664-5281 (1)

## IMPROVEMENT PERMIT / AUTHORIZATION TO CONSTRUCT / OPERATION PERMIT / EXISTING SYSTEM INSPECTION

PERMIT # 160902 PIN # 4705-24-8164 DATE 26 May 10

OWNER or APPLICANT Randy Wilson / Wilson Bldg. PHONE: Business (704) 880-9219 Home:

OWNER or APPLICANT ADDRESS P.O. Box 6628 Statesville, N.C.

LOCATION / DIRECTIONS 311 Mosby Deal Rd.

SUBDIVISION Poindexter Farms BLOCK / SECTION LOT # 8 LOT AREA 0.92 ac. DESIGN FLOW 360 g/d L.T.A.R. 0.3 g/ft²/d

Septic Tank 1000 Gallons: STB 1012 Date 3-23-09

Pump Tank Gallons: PT Date

Pump Make Model Serial #

Nitrification Field No Fields 1 No Lines 4 Linear Feet 300

Trench Width 36" Max. Trench Bottom Depth 36" Gravel Depth NA

☑ New System ☐ Repair ☐ Expansion System Type I II (III) IV V VI

System Description: 25% Reduction System

Repair System Description: 25% Reduction

Maintenance Agreement Required ☐ YES ☒ NO

☑ GRAVITY ☐ PRESSURE

☑ Residence No. Bedrooms 3

☐ Business No. Persons

☐ Other No. Employees

☐ Slab ☑ Crawl Space


☐ Basement w/plumbing ☐ Basement w/o plumbing

Water Supply: ☐ Private ☑ Public ☐ Community


Comments / Conditions: Follow contour /

Comments / Conditions

INITIAL SITE SKETCH

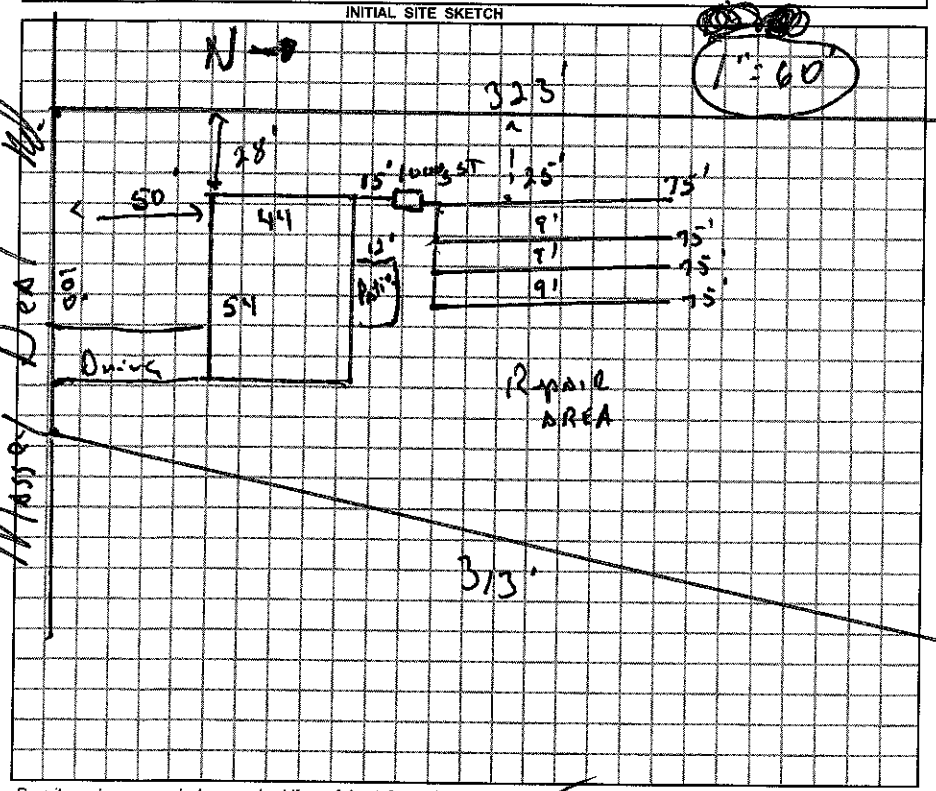


AS BUILT SKETCH

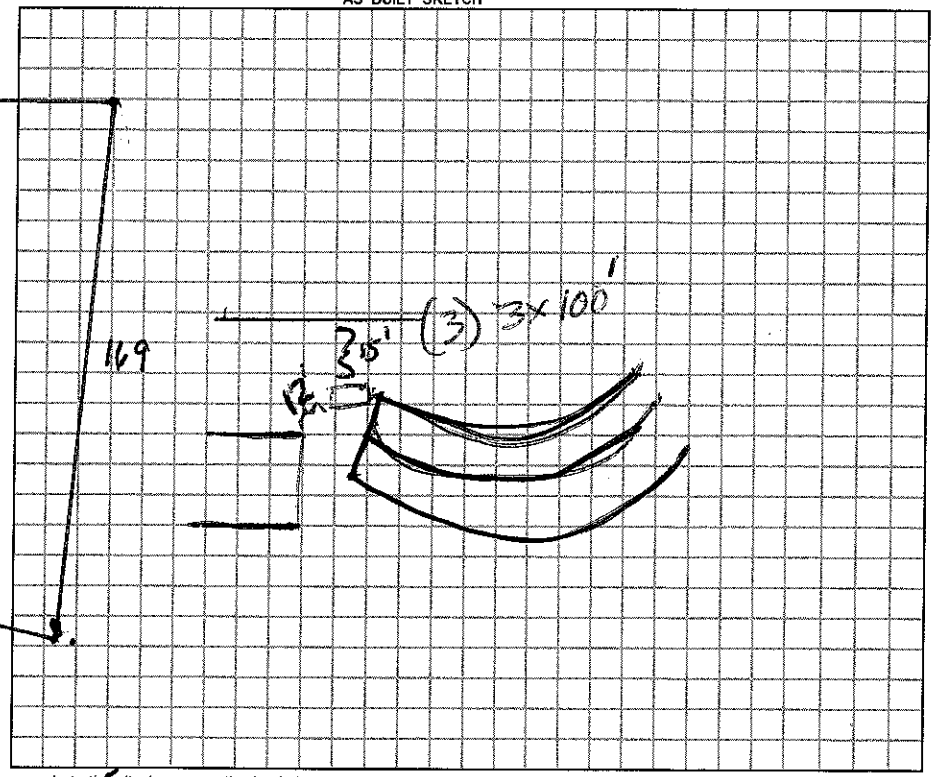


*Permit can be suspended or revoked if any false information is supplied toward securing the permit / any unauthorized changes are made to the site / any unauthorized changes are made in the installation of the system.*

☐ *IMPROVEMENT PERMIT w / plan valid without expiration.* ☑ *IMPROVEMENT PERMIT w / site plan valid for 60 mos.* ☑ *AUTHORIZATION TO CONSTRUCT valid for period equal to IMPROVEMENT PERMIT-not to exceed 60 mo.*

Owner / Applicant Signature: Randy Wilson Date 5-27-2010

Improvement Permit by: [signature] R.S. Date 26 May 2010

Authorzation to Construct by: [signature] R.S. Date 26 May 2010

Installed by: Piedmont Grading

Operation Permit by: [signature] Date: 9-18-10

Existing System Inspected by: Date:

***YOU SHOULD CONTACT A LOCATOR SERVICE PRIOR TO ANY EXCAVATION.***

WHITE COPY Environmental Health YELLOW COPY (Final) Owner / Applicant PINK COPY (Initial) Owner / Applicant