IREDELL COUNTY HEALTH DEPARTMENT

STATESVILLE 704-878-5305 MOORESVILLE 704-664-5281

IMPROVEMENT PERMIT / AUTHORIZATION TO CONSTRUCT / OPERATION PERMIT / EXISTING SYSTEM INSPECTION

PERMIT # R-0017R PIN # 4705-26-8913 DATE 3 February 2010

OWNER or APPLICANT Iva Herzog PHONE: Business Home: (704) 873-8040

OWNER or APPLICANT ADDRESS 637 Lippard Farm Rd. Statesville NC

LOCATION / DIRECTIONS Hwy 64 towards Taylorsville TL Lippard Farm Rd. on Rt. post Single Lw.

SUBDIVISION BLOCK / SECTION LOT # LOT AREA 176 AC. DESIGN FLOW 240 gpd L.T.A.R. 0.2 /576

Septic Tank 1000 Gallons: STB 760 Date 8-6-09

Pump Tank Gallons: P T Date

Pump Make Model Serial #

Nitrification Field No Fields 1 No Lines 1 Linear Feet 100

Trench Width 36" Max. Trench Bottom Depth 36" Gravel Depth N/A

☐ New System ☑ Repair ☐ Expansion System Type I (II) III IV V VI

System Description:

Repair System Description: 25% Reduction

Maintenance Agreement Required ☐ YES ☑ NO

☑ GRAVITY ☐ PRESSURE

☑ Residence No. Bedrooms 2

☐ Business No. Persons

☐ Other No. Employees

☐ Slab ☑ Crawl Space


☐ Basement w/plumbing ☐ Basement w/o plumbing

Water Supply: ☐ Private ☑ Public ☐ Community


Comments / Conditions: Add new septic tank. / Pump & Abandon old tank / Install Drop-boxes on existing lines.

Comments / Conditions

INITIAL SITE SKETCH

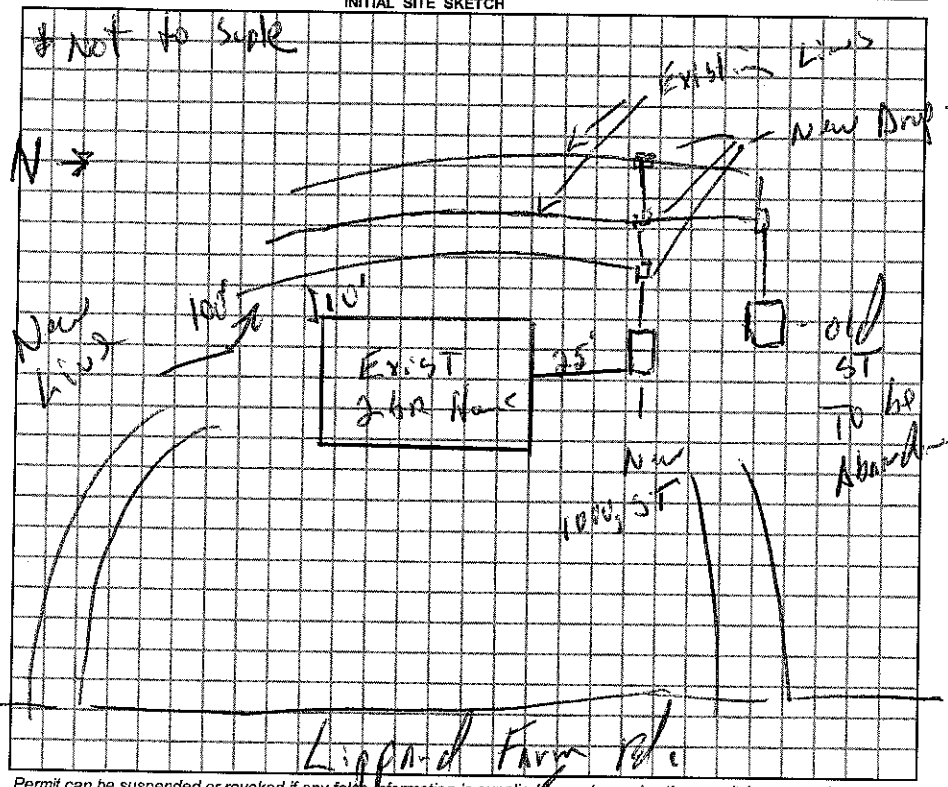

AS BUILT SKETCH

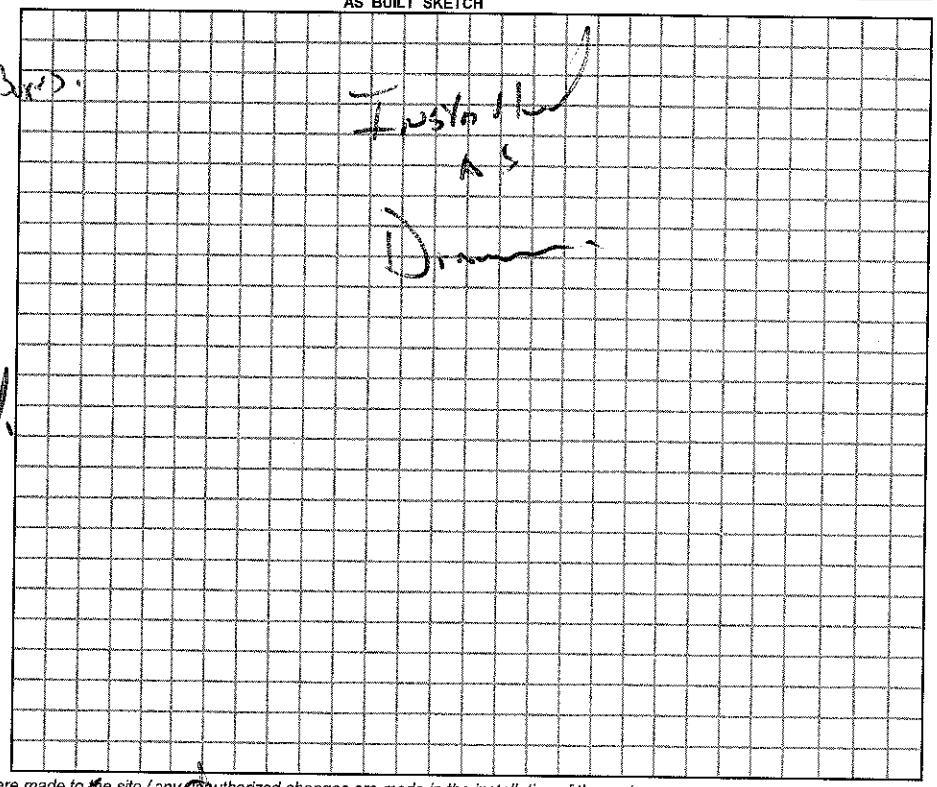

Permit can be suspended or revoked if any false information is supplied toward securing the permit / any unauthorized changes are made to the site / any unauthorized changes are made in the installation of the system.

☐ *IMPROVEMENT PERMIT w / plat valid without expiration.* ☑ *IMPROVEMENT PERMIT w / site plan valid for 60 mos.* ☑ *AUTHORIZATION TO CONSTRUCT valid for period equal to IMPROVEMENT PERMIT-not to exceed 60 mo.*

Owner / Applicant Signature: Date 12 FEB

Improvement Permit by: R.S. Date 8 Feb. 10

Authorization to Construct by: R.S. Date 8 Feb. 10

YOU SHOULD CONTACT A LOCATOR SERVICE PRIOR TO ANY EXCAVATION.

Installed by: Date:

Operation Permit by: R.S. Date: 12 Feb. 10

Existing System Inspected by: Date:

WHITE COPY Environmental Health YELLOW COPY (Final) Owner / Applicant PINK COPY (Initial) Owner / Applicant