IREDELL COUNTY HEALTH DEPARTMENT

STATESVILLE 704-878-5305 MOORESVILLE 704-664-5281

IMPROVEMENT PERMIT / AUTHORIZATION TO CONSTRUCT / OPERATION PERMIT / EXISTING SYSTEM INSPECTION

PERMIT# Repair PIN# 4705-31-3023 30-3818 DATE 7-9-09

OWNER OR CONTRACTOR Edward Ferguson PHONE: Business 704 873 6966 Home

ADDRESS 341 Alpine Circle, Stvl. 28625

LOCATION 140W to OMR, (R) on Alpine Circle # 341 Alpine

SUBDIVISION Alexanders Knoll BLOCK / SECTION LOT 36 LOT AREA .646 SITE CLASS PS DESIGN FLOW Ex L.T.A.R. Ex

Septic Tank: 1000 Gallons; STB Ex Date

Pump Tank: Gallons; PT Date

Pump Make: Model Serial No.

Nitrification Field: No Fields Ex Square Feet Ex Linear Feet Ex

No Lines Ex Trench Width Ex Max Trench Bottom Depth Ex Gravel Depth

☐ New System ☐ Repair System Type: I II III IV V VI

System Description: 25% Reduction Ex

Repair System Description:

Maintenance Agreement Required: ☐ Yes ☒ No

☒ House/Mod. Home No. Bedrooms 3

☐ Mobile Home No. Bathrooms

☐ Business No. Employees

☐ Other

☐ Slab ☒ Crawl Space ☐ Basement w/plumbing ☐ Basement wo/plumbing


Water Supply: ☐ Individual ☒ Public ☐ Community

Comments:/Conditions:

Add risers to bring tank entrance within 6" of ground surface (Top of tank deeper than 6".)

Comments:/Conditions:

INITIAL SITE SKETCH

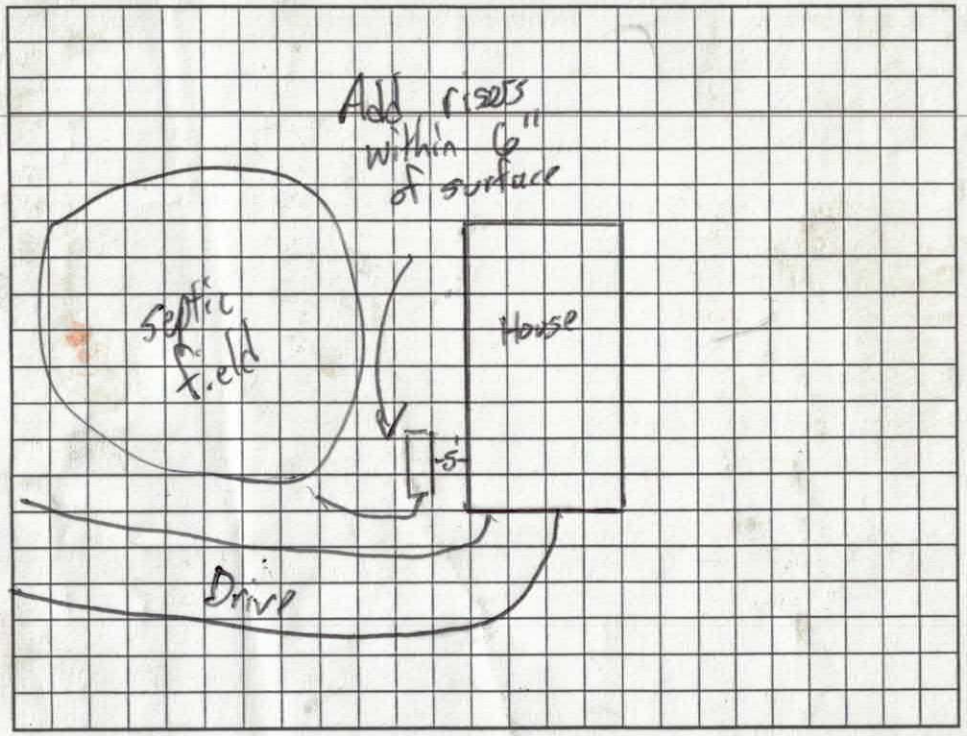

AS BUILT SKETCH

Permit can be suspended or revoked if any false information is supplied toward securing the permit/any unauthorized changes are made to the site/any unauthorized changes are made in the installation of the system. Improvement Permit with plat valid without expiration. Improvement Permit with site plan valid for sixty months. Authorization to Construct is valid for a period equal to that of Improvement Permit – not to exceed sixty months.

Signed: date

Improvement Permit by: date

Authorization to Construct by: date 7-9-09

Installed by: Tommy Frye

Operation Permit by: date 7-9-09

Existing System Inspection by: date

HEALTH DEPT. COPY: WHITE OWNER COPY (FINAL): YELLOW OWNER COPY (INITIAL): PINK