IREDELL COUNTY HEALTH DEPARTMENT

STATESVILLE 704-878-5305 (CI) MOORESVILLE 704-664-5281

IMPROVEMENT PERMIT / AUTHORIZATION TO CONSTRUCT / OPERATION PERMIT / EXISTING SYSTEM INSPECTION

PERMIT# 13261 PIN# 4705 30 5550 DATE 6-16-06

OWNER OR APPLICANT Heritage Building Company PHONE: Business 701-528-6644 Home

ADDRESS 208 Hickory Point Court Statesville NC 28677

LOCATION Off RD, Alpine Circle (RD) Lot 29 Lot

SUBDIVISION Alexander Knoll BLOCK / SECTION LOT 30 LOT AREA .69 SITE CLASS. PS DESIGN FLOW 360 L.T.A.R. .3

Septic Tank: 1000 Gallons; STB 1012 Date 11-1905

Pump Tank: Gallons; PT Date

Pump Make: Model Serial No.

Nitrification Field: No Fields Square Feet 1200 Linear Feet 300

No Lines 5 Trench Width 36 Max Trench Bottom Depth 36 Gravel Depth 11

☑ New System ☐ Repair ☐ Expansion System Type: I (II) III IV V VI

System Description: 25% Grav Red

Repair System Description: Pump 25%

Maintenance Agreement Required: ☐ Yes ☐ No

☐ House/Mod. Home No. Bedrooms 3

☐ Mobile Home No. Persons

☐ Business No. Employees

☐ Other


Water Supply: ☐ Individual ☑ Public ☐ Community

☐ Gravity ☐ Pressure ☐ Slab ☑ Crawl Space ☐ Basement w/plumbing ☐ Basement wo/plumbing

Comments:/Conditions:

Installed on Contour
Maintain all setbacks

INITIAL SITE SKETCH

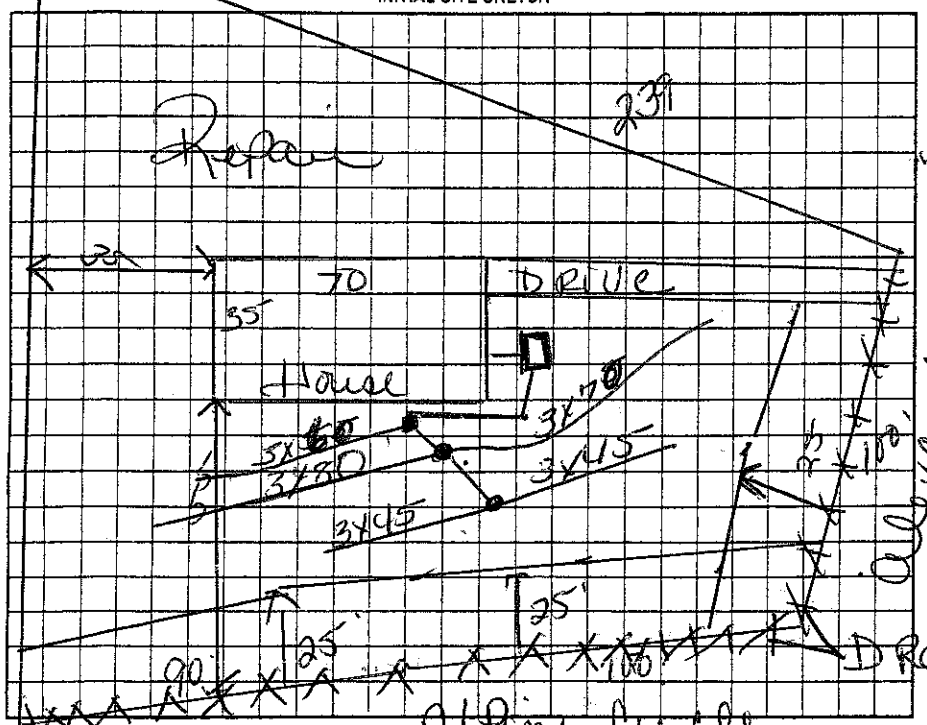


Comments:/Conditions:

Yellow Tag - Site Filter
Septic Tank System
Line 1 has 6' infiltrators
Line 2-3 - 4' infiltrators

AS BUILT SKETCH

1" = 60'

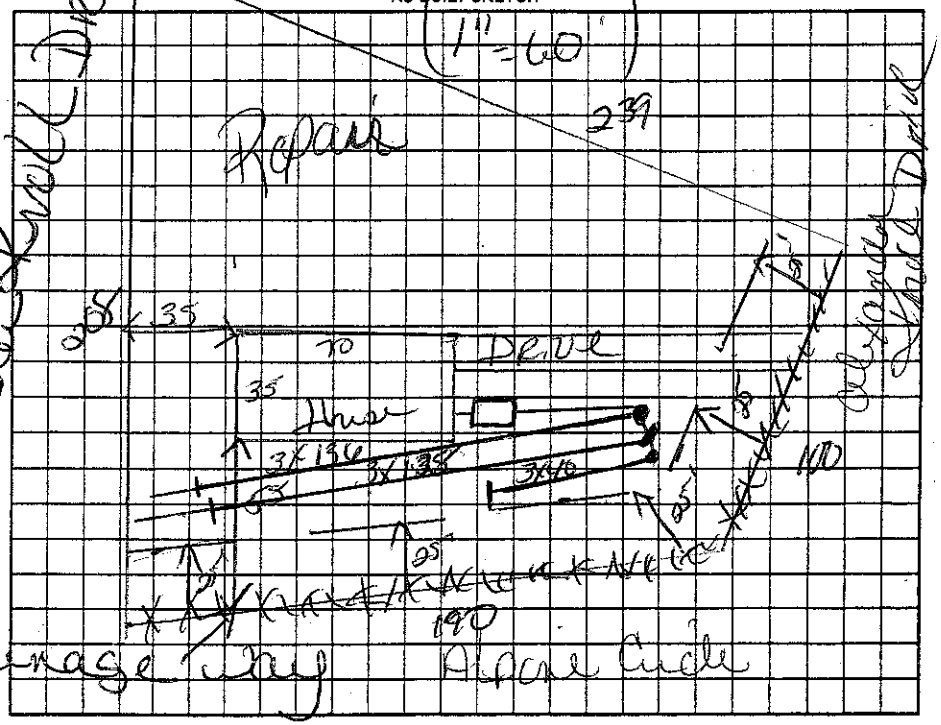

Permit can be suspended or revoked if any false information is supplied toward securing the permit/any unauthorized changes are made to the site/any unauthorized changes are made in the installation of the system. Improvement Permit with plat valid without expiration ☐ Improvement Permit with site plan valid for sixty months ☐ Authorization to Construct is valid for a period equal to that of Improvement Permit – not to exceed sixty months.

Signed: date 6-16-06 Installed by: Tommy Fryl

Improvement Permit by: Kelly Cook date 6-16-06 Operation Permit by: Kelly Cook date 6-19-06

Authorization to Construct by: Kelly Cook date 6-16-06 Existing System Inspection by: date

HEALTH DEPT. COPY: WHITE OWNER COPY (FINAL): YELLOW OWNER COPY (INITIAL): PINK