IREDELL COUNTY HEALTH DEPARTMENT

STATESVILLE 704-878-5305 CI MOORESVILLE 704-664-5281

IMPROVEMENT PERMIT / AUTHORIZATION TO CONSTRUCT / OPERATION PERMIT / EXISTING SYSTEM INSPECTION

PERMIT# 136 [illegible] PIN# 4705 37 8103 05602 DATE 7-11-06

OWNER OR APPLICANT Heritage Builders PHONE: Business 704-528-6044 Home

ADDRESS 120 Hickory Point Court Statesville NC 28677

LOCATION I-40 W to 21 to Alpine Cr to Alexander Knoll Dr Property on left

SUBDIVISION Alexander Knoll BLOCK / SECTION LOT 48 LOT AREA .75 SITE CLASS. DESIGN FLOW 360 L.T.A.R. .3

Septic Tank: 1000 Gallons; STB 1012 Date 3-7-06

Pump Tank: Gallons; PT Date

Pump Make: Model Serial No.

Nitrification Field: No Fields Square Feet 600 Linear Feet 300

No Lines 4 Trench Width 36" Max Trench Bottom Depth 36" Gravel Depth NH ☒ Gravity ☐ Pressure

☒ New System ☐ Repair ☐ Expansion System Type I II III IV V VI

System Description: 25% Expand

Repair System Description: 25% Reduction

Maintenance Agreement Required: ☐ Yes ☐ No

☐ House/Mod. Home No. Bedrooms 3

☐ Mobile Home No. Persons

☐ Business No. Employees

☐ Other


Water Supply: ☐ Individual ☒ Public ☐ Community

☐ Slab ☒ Crawl Space ☐ Basement w/plumbing ☐ Basement wo/plumbing

Comments:/Conditions: Install on Contour
Maintain all setbacks

Comments:/Conditions: Use distribution box with Speed levels

INITIAL SITE SKETCH

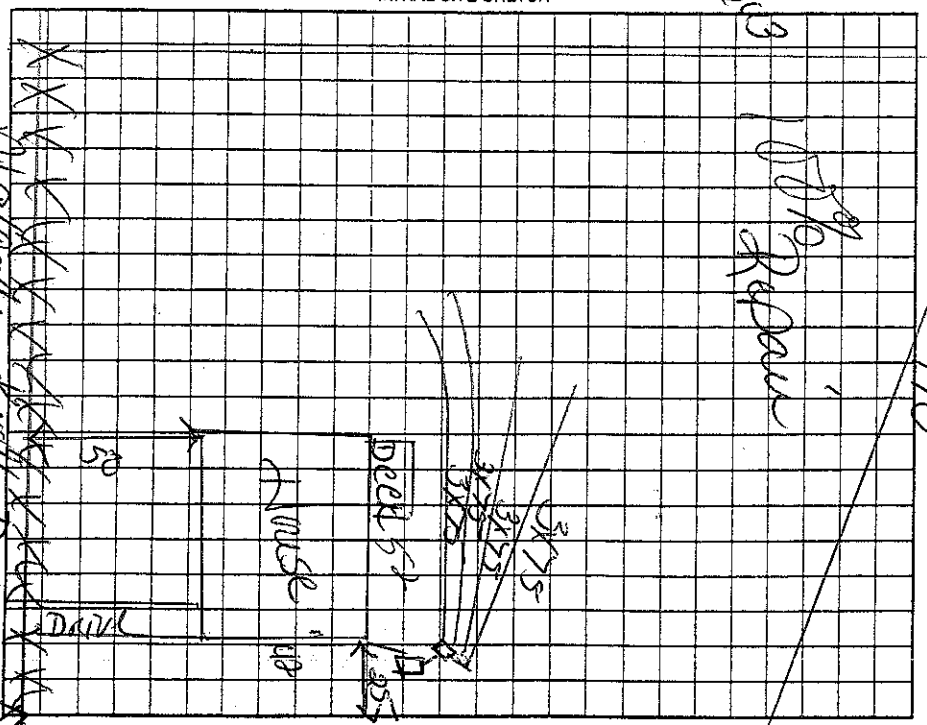

AS BUILT SKETCH

ST marker
Yellow Filter
No Riser

Permit can be suspended or revoked if any false information is supplied toward securing the permit/any unauthorized changes are made to the site/any unauthorized changes are made in the installation of the system. Improvement Permit with plat valid without expiration ☐ Improvement Permit with site plan valid for sixty months ☐ Authorization to Construct is valid for a period equal to that of Improvement Permit – not to exceed sixty months.

Signed: date 7-11-06

Improvement Permit by: date 7-11-06

Authorization to Construct by: date 7-11-06

Installed by: Tommy Frye

Operation Permit by: date 9-21-06

Existing System Inspection by: date

HEALTH DEPT. COPY: WHITE OWNER COPY (FINAL): YELLOW OWNER COPY (INITIAL): PINK