IREDELL COUNTY HEALTH DEPARTMENT

STATESVILLE 704-878-5305 (C+) MOORESVILLE 704-664-5281

IMPROVEMENT PERMIT / AUTHORIZATION TO CONSTRUCT / OPERATION PERMIT / EXISTING SYSTEM INSPECTION

PERMIT# 137081 PIN# 4703305735

OWNER OR APPLICANT Heritage Building DATE 8-4-06

ADDRESS 120 Hickory Point Court PHONE: Business 704-528-6644 Home

LOCATION I40 W (R) (R) Alexander Knoll 2nd Drive (R) lot on left

SUBDIVISION Alexander Knoll BLOCK / SECTION LOT 149 LOT AREA .56 SITE CLASS. PS DESIGN FLOW 360 L.T.A.R. .3

Septic Tank: 1000 Gallons; STB 1012 Date 3-7-06
Pump Tank: Gallons; PT Date
Pump Make: Model Serial No.
Nitrification Field: No Fields Square Feet 1200 Linear Feet 300
No Lines 4 Trench Width 36" Max Trench Bottom Depth 36" Gravel Depth NA ☐ Gravity ☐ Pressure

☑ New System ☐ Repair ☐ Expansion System Type: I II III IV V VI
System Description: 25% Gravel
Repair System Description: Panel Block w/Pcs
Maintenance Agreement Required: ☐ Yes ☐ No

☑ House/Mod. Home ☐ Mobile Home ☐ Business ☐ Other
No. Bedrooms 3 No. Persons No. Employees


Water Supply: ☐ Individual ☑ Public ☐ Community

☐ Slab ☑ Crawl Space ☐ Basement w/plumbing ☐ Basement wo/plumbing


Comments:/Conditions: Install on contour
Maintain all setbacks

Comments:/Conditions: 4@75 - distributor box
Speed levels

INITIAL SITE SKETCH

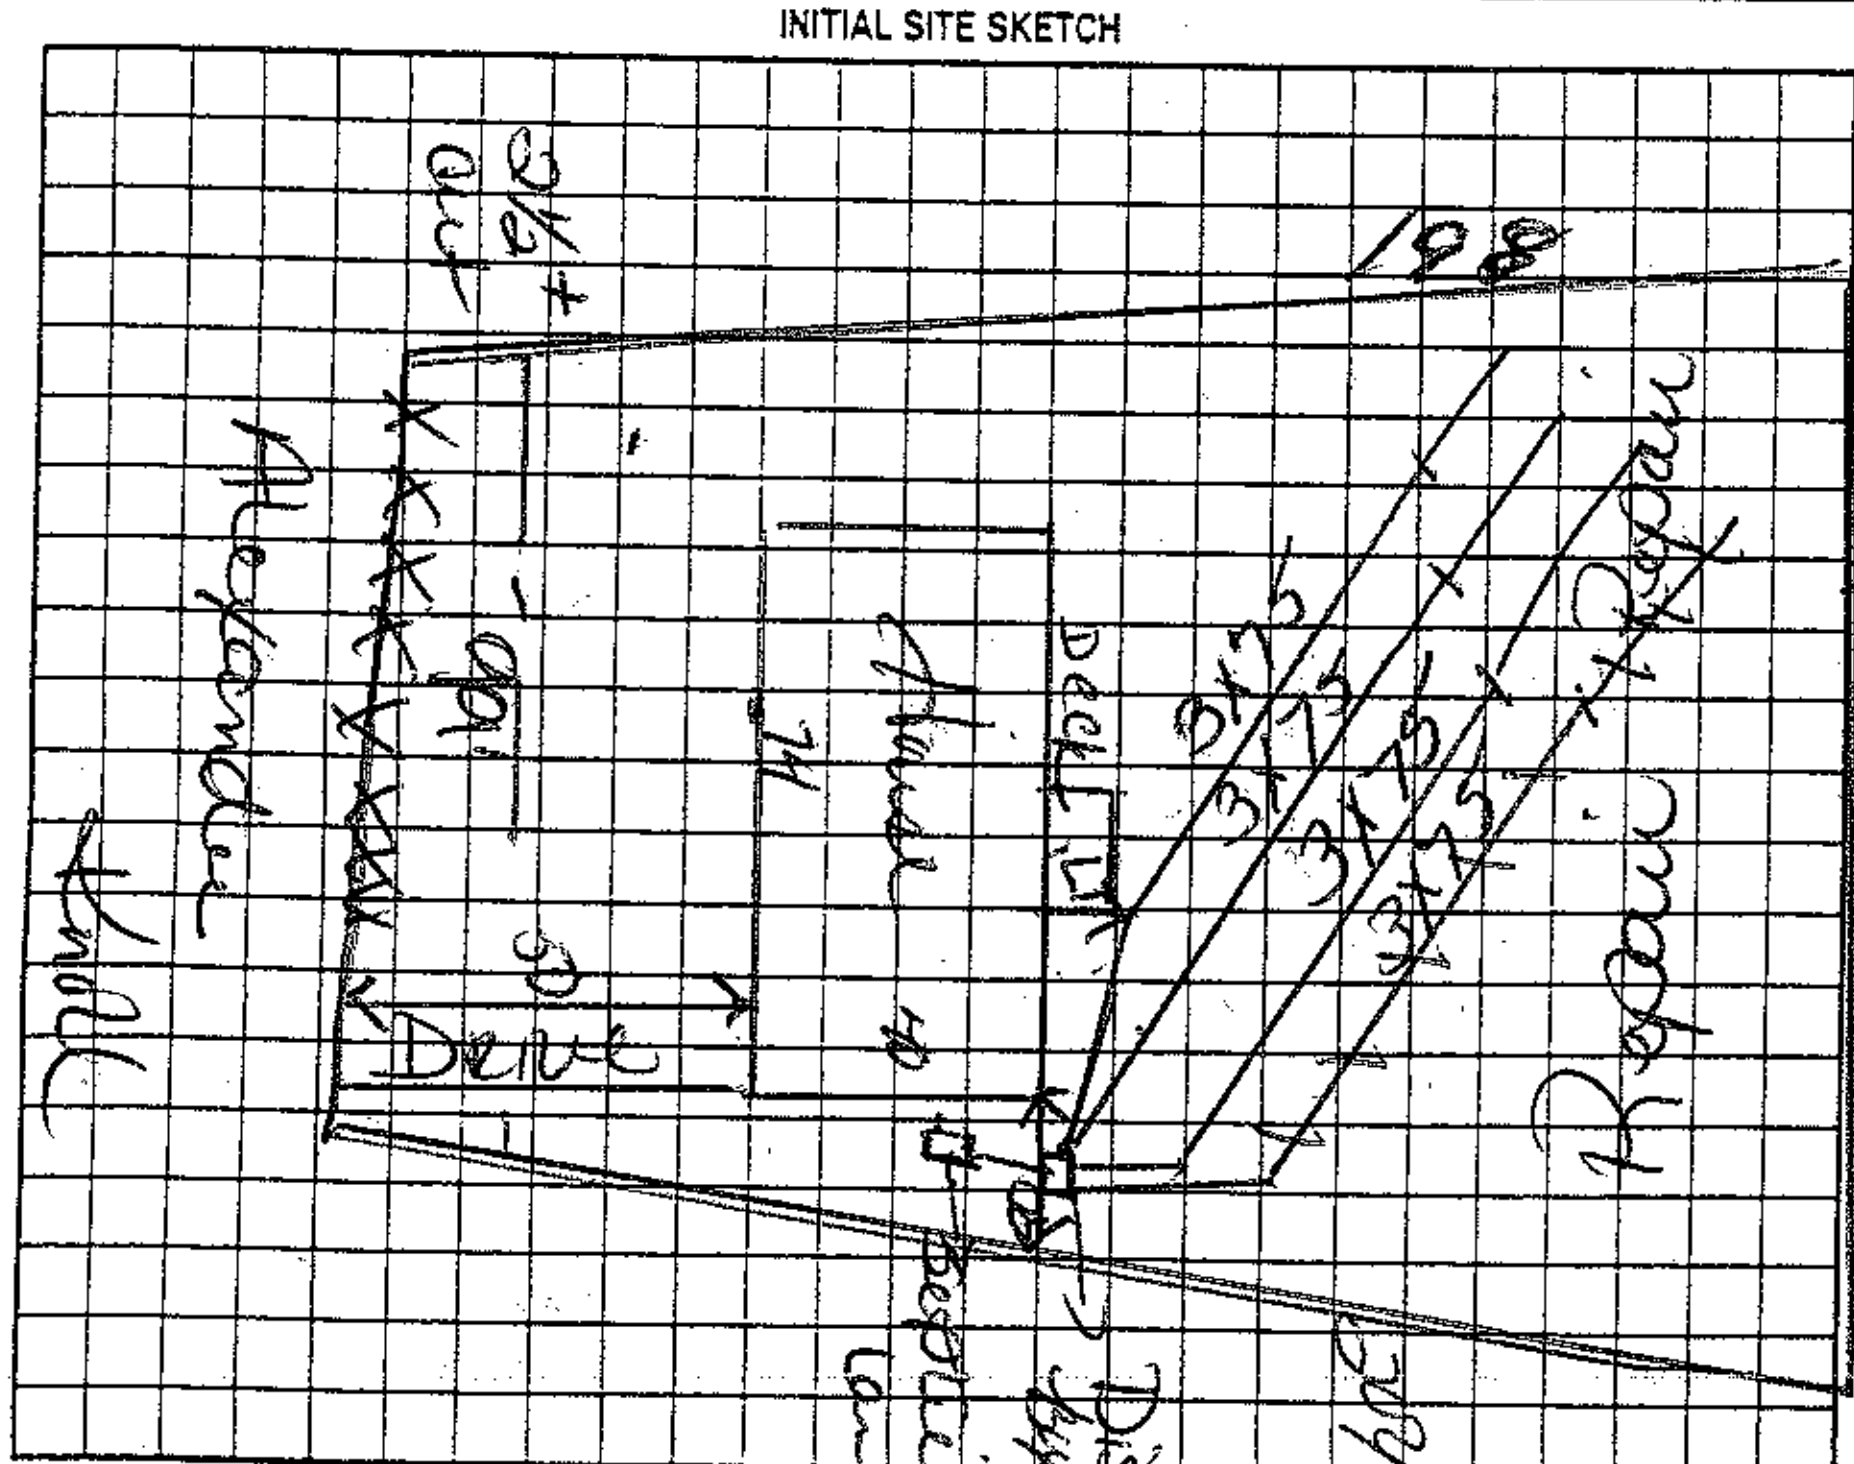

AS BUILT SKETCH

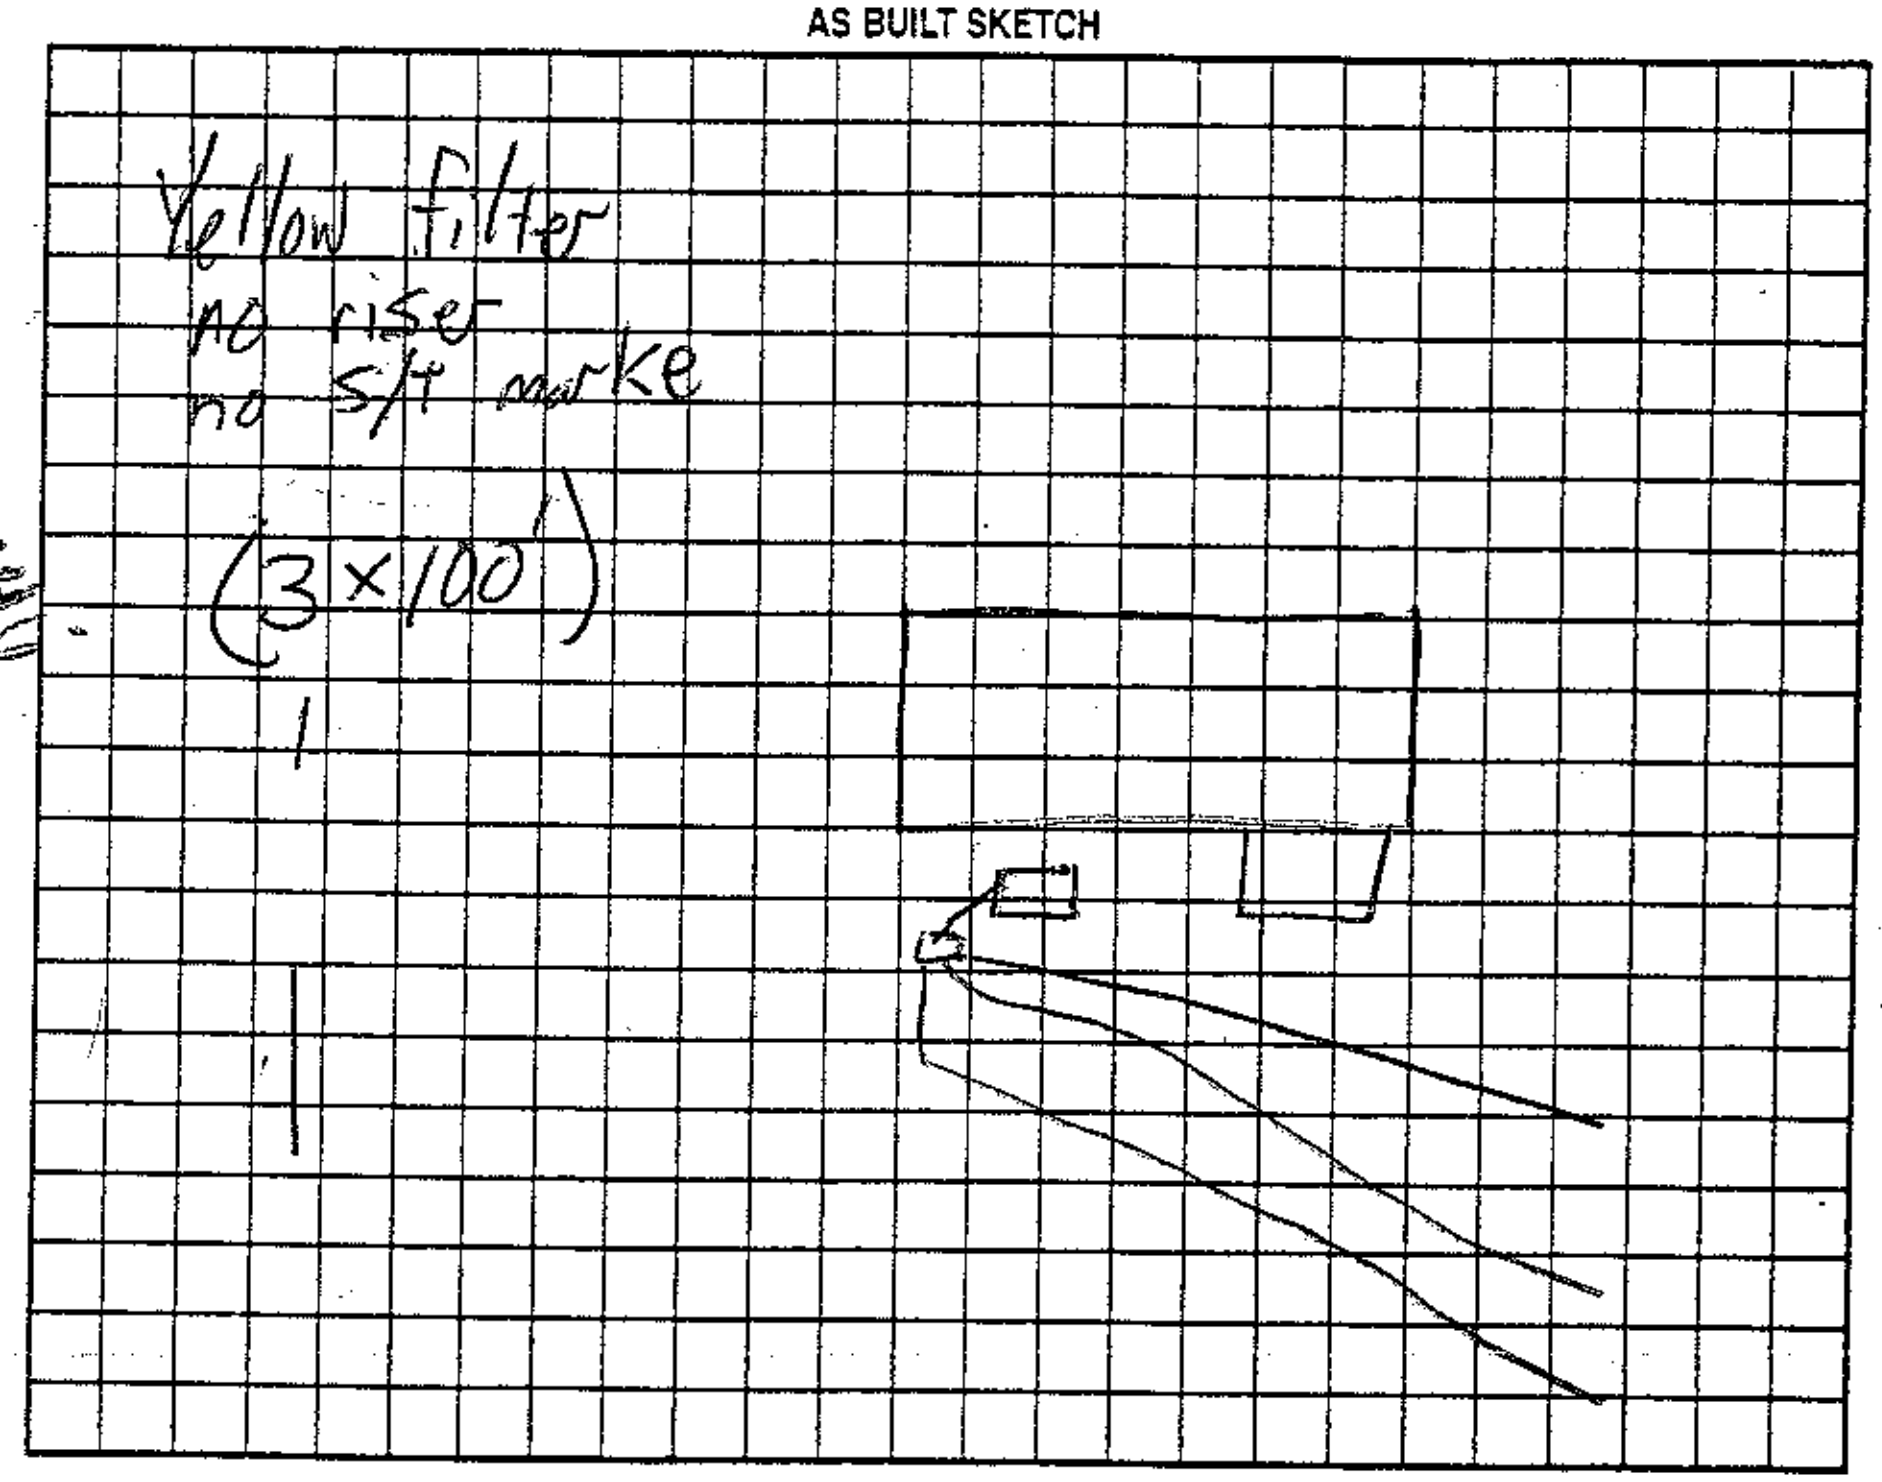

Permit can be suspended or revoked if any false information is supplied toward securing the permit/any unauthorized changes are made to the site/any unauthorized changes are made in the installation of the system. Improvement Permit with plat valid without expiration ☐ Improvement Permit with site plan valid for sixty months ☐ Authorization to Construct is valid for a period equal to that of Improvement Permit – not to exceed sixty months.

Signed: Carl S. Dixon date 8-4-06

Improvement Permit by: Kelly Cox date 8-4-06

Authorization to Construct by: Kelly Cox date 8-4-06

Installed by: Tommy Faye

Operation Permit by: [signature] date 9-21-06

Existing System Inspection by: date

HEALTH DEPT. COPY: WHITE OWNER COPY (FINAL): YELLOW OWNER COPY (INITIAL): PINK