IREDELL COUNTY HEALTH DEPARTMENT

STATESVILLE 704-878-5305 MOORESVILLE 704-664-5281

IMPROVEMENT PERMIT / AUTHORIZATION TO CONSTRUCT / OPERATION PERMIT / EXISTING SYSTEM INSPECTION

PERMIT# 143251 PIN# 4705308905 DATE 16 July 07

OWNER OR APPLICANT Heritage Building Co. PHONE: Business 704-902-4680 Home 704-538-6644

ADDRESS 120 Hickory Point Statesville, NC.

LOCATION OMB Turn into Alpine Cr. TL Alexander Knoll Dr. Lot on Rt.

SUBDIVISION Alexander Knoll BLOCK / SECTION 2 LOT 59 LOT AREA 0.647ac. SITE CLASS. AS DESIGN FLOW 360gpd. L.T.A.R. 0.3/0.4/FT

Septic Tank: 1000 Gallons; STB 1013-1050 Date 4-3-07

Pump Tank: _____ Gallons; PT _____ Date _____

Pump Make: _____ Model _____ Serial No. _____

Nitrification Field: No Fields 1 Square Feet = 1200 Linear Feet 300

No Lines 4 Trench Width 36" Max Trench Bottom Depth 30" Gravel Depth _____

☑ New System ☐ Repair ☐ Expansion System Type: I II III IV V VI

System Description: 25% Reduction

Repair System Description: 25% Reduction

Maintenance Agreement Required: ☐ Yes ☑ No

☑ House/Mod. Home No. Bedrooms 3

☐ Mobile Home No. Persons ____

☐ Business No. Employees ____

☐ Other _____

Water Supply: ☐ Individual ☑ Public ☐ Community

☑ Gravity ☐ Pressure ☐ Slab ☑ Crawl Space ☐ Basement w/plumbing ☐ Basement wo/plumbing

Comments:/Conditions: Follow Contour

Comments:/Conditions: Tough-Tile filter ST Has mark.

INITIAL SITE SKETCH

See Attached site plan

AS BUILT SKETCH

Installed AS Drawn

Permit can be suspended or revoked if any false information is supplied toward securing the permit/any unauthorized changes are made to the site/any unauthorized changes are made in the installation of the system. Improvement Permit with plat valid without expiration ☐ Improvement Permit with site plan valid for sixty months ☑ Authorization to Construct is valid for a period equal to that of Improvement Permit – not to exceed sixty months.

Signed: _____ date 7-16-07

Improvement Permit by: _____ R.S. date 16 July 07

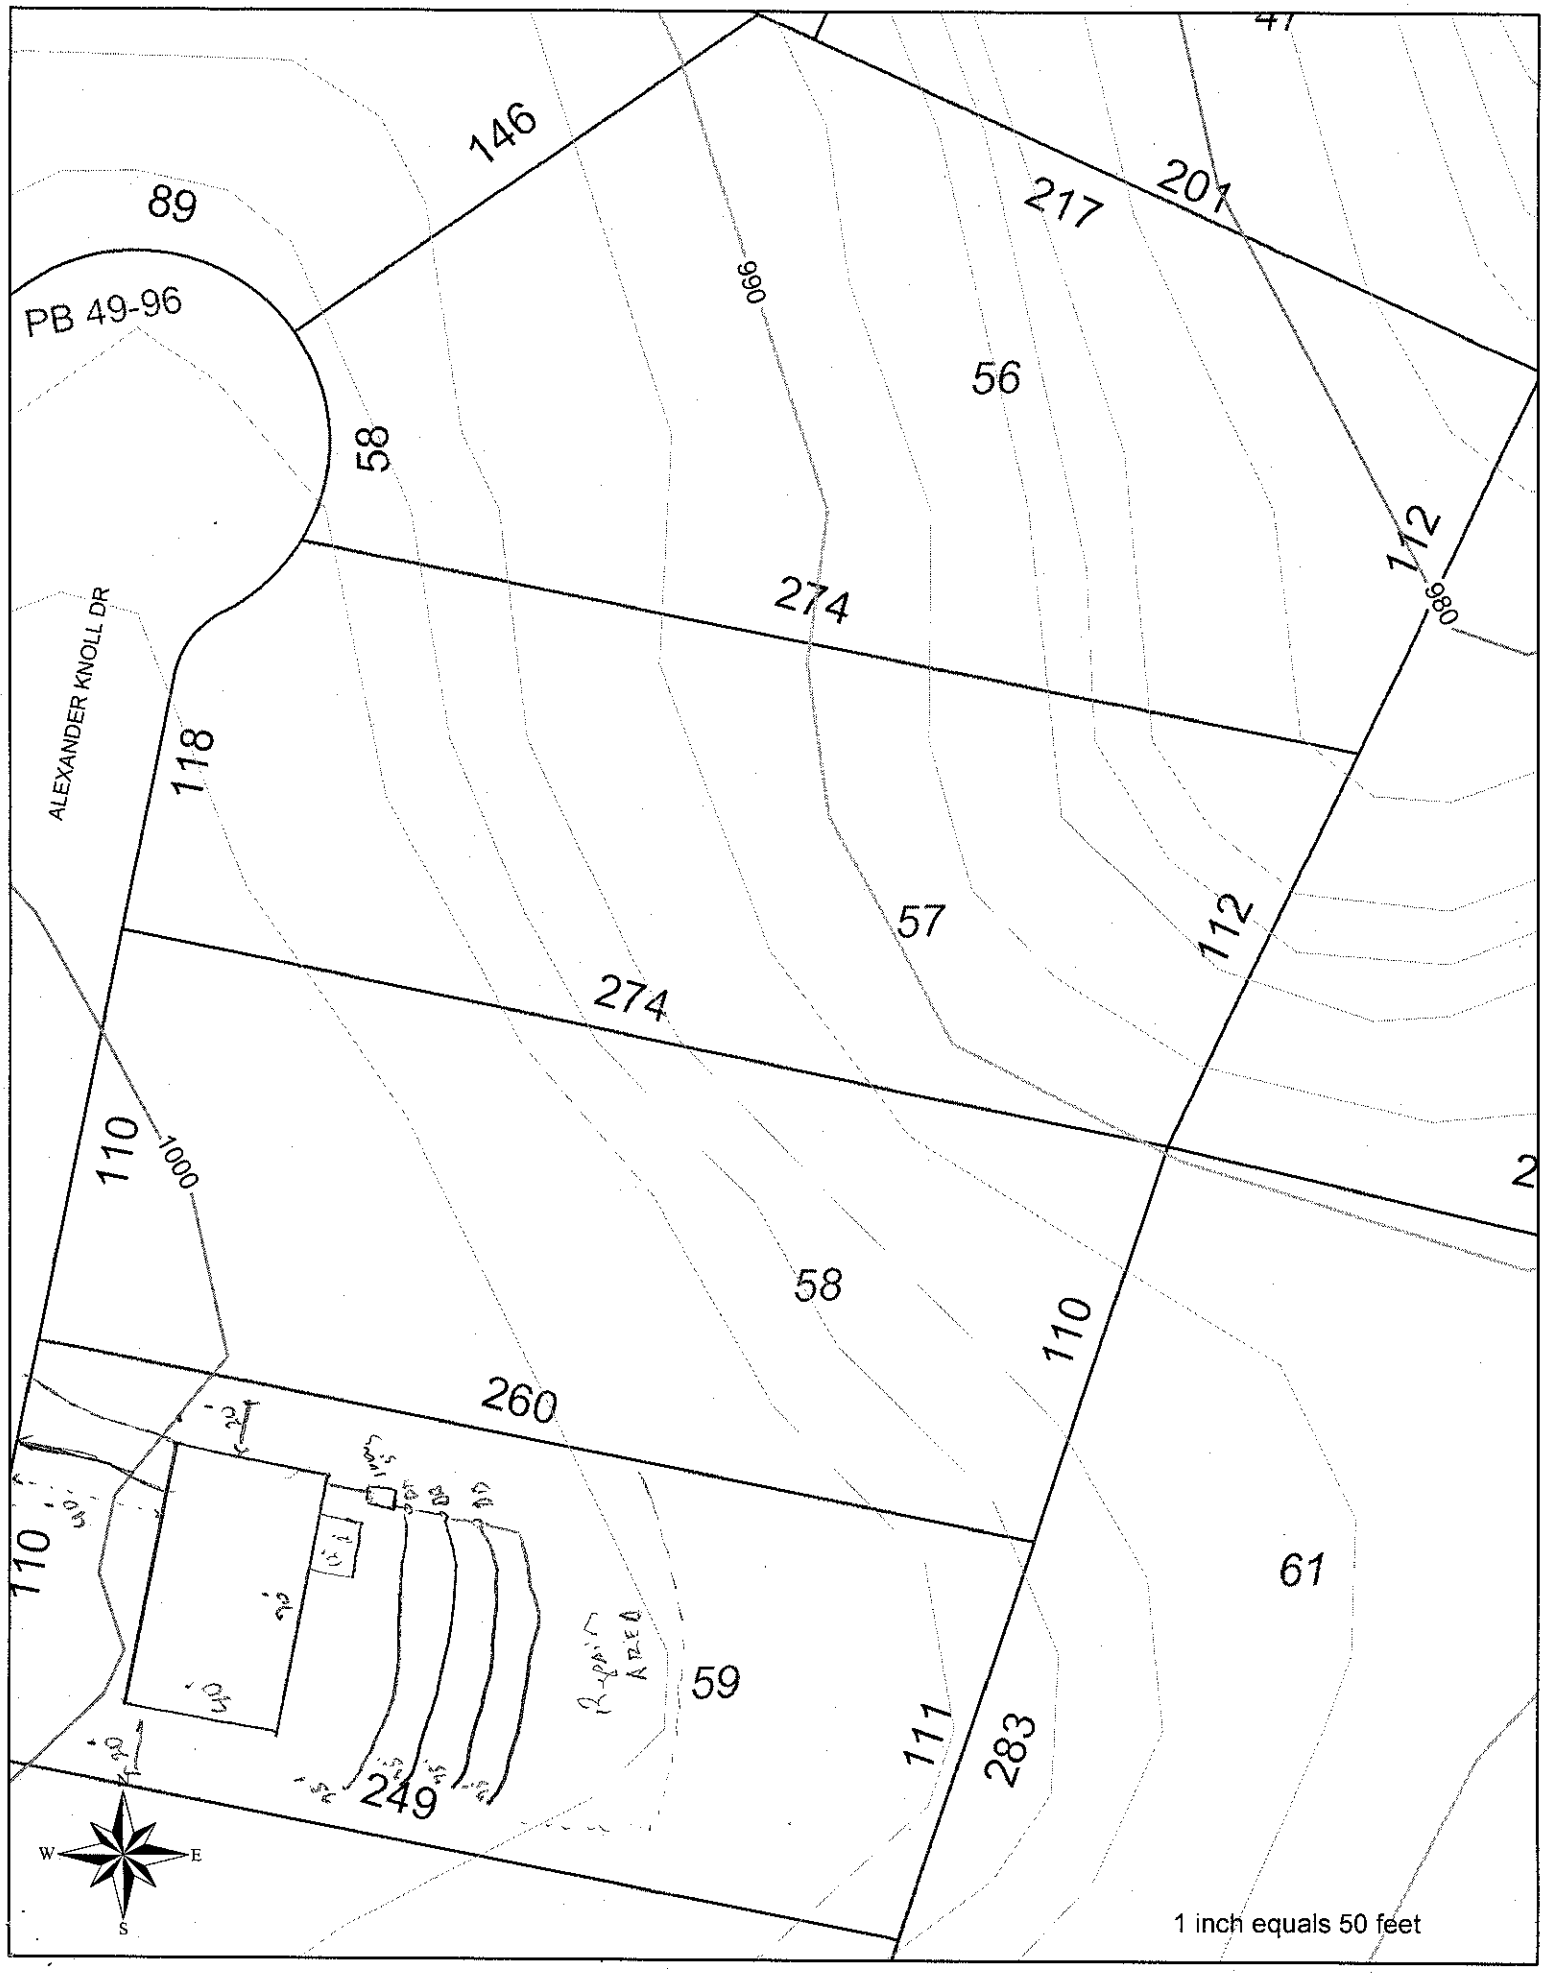
Authorization to Construct by: _____, R.S. date 16 July 07

Installed by: Frye Grading

Operation Permit by: _____, R.S. date 8 October 07

Existing System Inspection by: _____ date _____

HEALTH DEPT. COPY: WHITE OWNER COPY (FINAL): YELLOW OWNER COPY (INITIAL): PINK


146
89
PB 49-96
217
201
990
56
58
112
274
980
ALEXANDER KNOLL DR
118
57
112
274
110
1000
58
110
260
61
110
59
111
283
249
1 inch equals 50 feet