IREDELL COUNTY HEALTH DEPARTMENT

STATESVILLE 704-878-5305 CI MOORESVILLE 704-664-5281

IMPROVEMENT PERMIT / AUTHORIZATION TO CONSTRUCT / OPERATION PERMIT / EXISTING SYSTEM INSPECTION

PERMIT# 107656 PIN# 4705-31-3124

OWNER OR CONTRACTOR Heritage Bldg Company PHONE: Business (704) 528-6644 Home — DATE 9/25/02

ADDRESS 120 Hickory Place Court Statesville N.C. 28677

LOCATION I-40W, @ on Old Mtn Rd., @ on Alpine Circle Turn Left into Subdivision on Right

SUBDIVISION Alexander Pond BLOCK / SECTION — LOT 38 LOT AREA .626 SITE CLASS P5 DESIGN FLOW 360 L.T.A.R. .40

Septic Tank: 4000 Gallons: STB 1012 Date 6-30-02
Pump Tank: — Gallons: PT — Date —
Pump Make: — Model 4" to Serial No 225
Nitrification Field: No Fields 1 Square Feet 900 Linear Feet 300
No Lines 3 Trench Width 36" Max Trench Bottom Depth 32" Gravel Depth N/A

[X] New System [ ] Repair System Type: I II III IV V VI
System Description: Gravity, 25% Red.
Repair System Description: Pump, 25% Reduction
Maintenance Agreement Required: [ ] Yes [X] No
[ ] Slab [X] Crawl Space [ ] Basement w/plumbing [ ] Basement wo/plumbing


[X] House/Mod. Home No. Bedrooms 3
[ ] Mobile Home No. Bathrooms 2
[ ] Business No. Employees —
[ ] Other —

Water Supply: [ ] Individual [X] Public [ ] Community


Comments/Conditions: ① Install French Drain around Septic System 48" deep & going to day light

Comments/Conditions: - Tuff-Tite Filter Installed
- S.T. Marked Installed
- 39 Infiltrator Chambers Installed

INITIAL SITE SKETCH 1"=50'

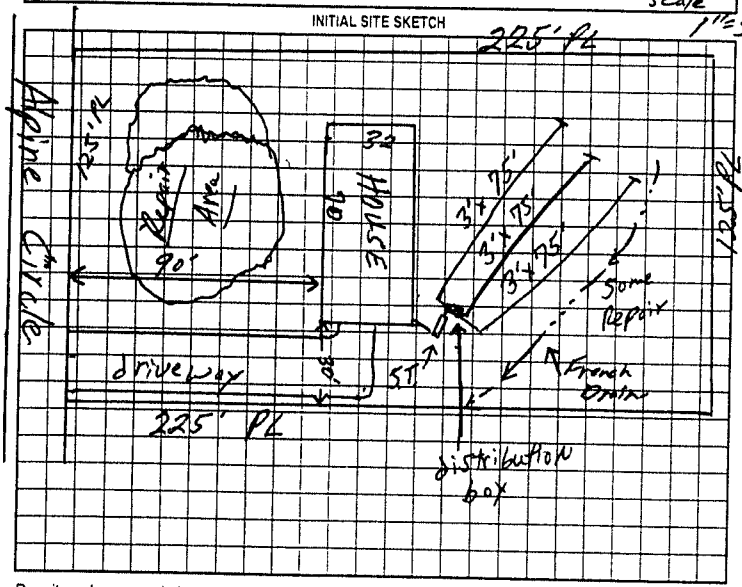

AS BUILT SKETCH

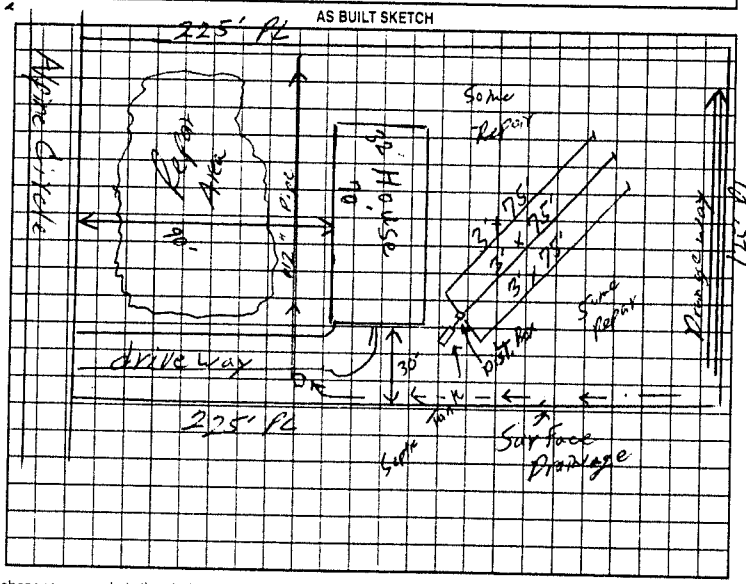

Permit can be suspended or revoked if any false information is supplied toward securing the permit/any unauthorized changes are made to the site/any unauthorized changes are made in the installation of the system. Improvement Permit with plat valid without expiration. Improvement Permit with site plan valid for sixty months. Authorization to Construct is valid for a period equal to that of Improvement Permit – not to exceed sixty months

Signed: [signature] date 9/9/02 Installed by Tommy Frye

Improvement Permit by: William O. Johnson date 7/25/02 Operation Permit by: William O. Johnson date 12/2/02

Authorization to Construct by: William O. Johnson date 7/25/02 Existing System Inspection by: — date —

HEALTH DEPT COPY: WHITE OWNER COPY (FINAL): YELLOW OWNER COPY (INITIAL): PINK