IREDELL COUNTY HEALTH DEPARTMENT

STATESVILLE 704-878-5305 MOORESVILLE 704-664-5281

IMPROVEMENT PERMIT / AUTHORIZATION TO CONSTRUCT / OPERATION PERMIT / EXISTING SYSTEM INSPECTION

PERMIT# 12 6502 PIN# 4705313559 96 DATE 7-8-05

OWNER OR CONTRACTOR Heritage Bldrs. PHONE: Business 704-902-4680 Home

ADDRESS 120 Hickory Bank Court Statesville

LOCATION Old Mt Ruby Road @ Alpine circle - around curve on left

SUBDIVISION Alexander Knoll BLOCK / SECTION LOT 41-42 LOT AREA 1.2 AC. SITE CLASS PS DESIGN FLOW 360 L.T.A.R. .3

Septic Tank: 1000 Gallons; STB 1012 Date 3/7/05
Pump Tank: Gallons; PT Date
Pump Make: Model Serial No.
Nitrification Field: No Fields Square Feet 1200 Linear Feet 300
No Lines 5 Trench Width 36" Max Trench Bottom Depth 36" Gravel Depth N/A

☑ New System ☐ Repair System Type: I II III IV V VI
System Description: 25% Red-Gravity
Repair System Description: Pump - Gravity
Maintenance Agreement Required: ☐ Yes ☑ No


☐ House/Mod. Home No. Bedrooms 3
☐ Mobile Home No. Bathrooms
☐ Business No. Employees
☐ Other
☐ Slab ☐ Crawl Space ☐ Basement w/plumbing ☐ Basement wo/plumbing

Water Supply: ☐ Individual ☑ Public ☐ Community


Comments:/Conditions: 36" Trench Depth
Stay 25' off Drainage Ditch
Haul pipe foundation drain to drainage ditch (1"=60')

Comments:/Conditions: ST W/ MARKER AND TNF-Tite FILTER INSTALLED WITH 25 QUICK-4 INFILTRATORS.

INITIAL SITE SKETCH

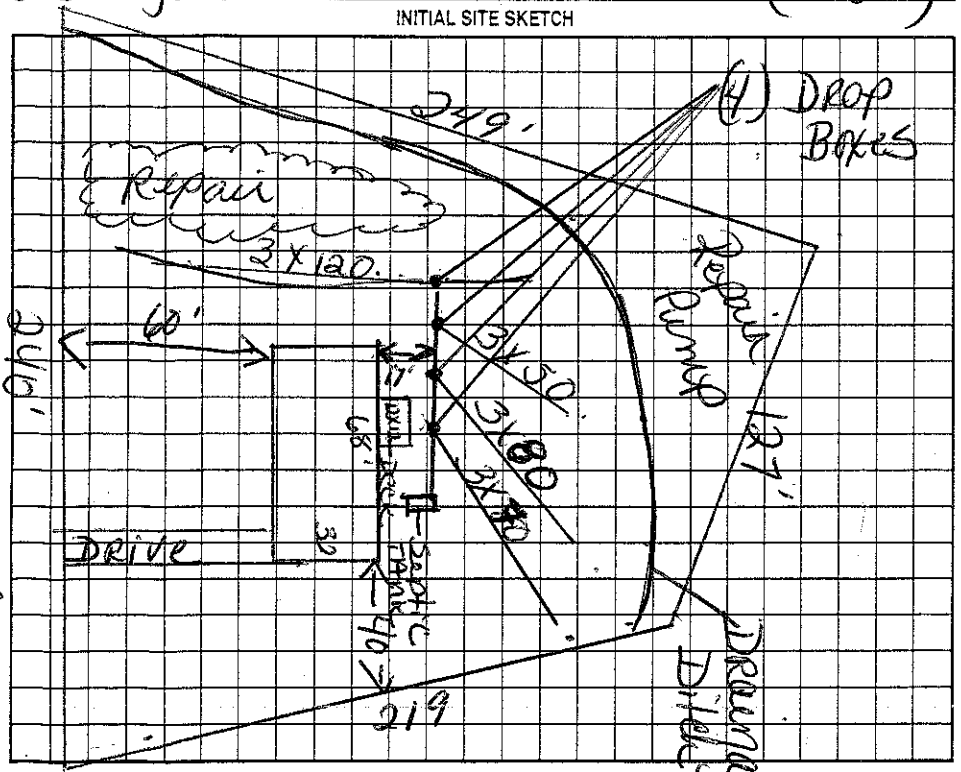

AS BUILT SKETCH

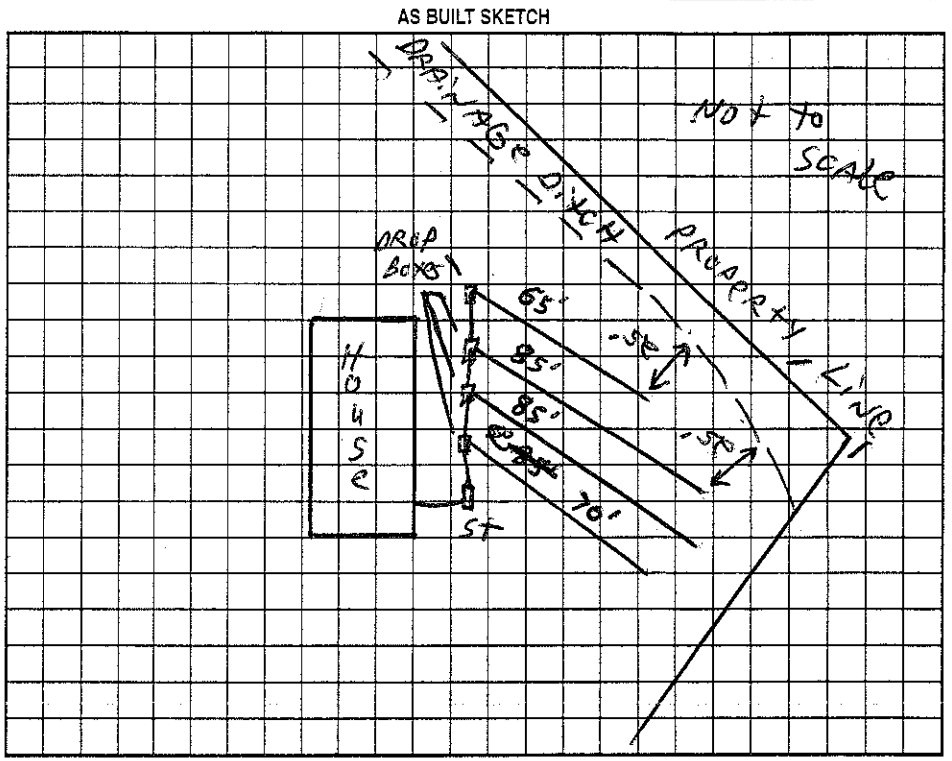

Permit can be suspended or revoked if any false information is supplied toward securing the permit/any unauthorized changes are made to the site/any unauthorized changes are made in the installation of the system. Improvement Permit with plat valid without expiration. Improvement Permit with site plan valid for sixty months. Authorization to Construct is valid for a period equal to that of Improvement Permit – not to exceed sixty months.

Signed: Sarah Dyson date 7-28-05 Installed by: TOMMY FRYE

Improvement Permit by: Kelly J Cook date 7-8-05 Operation Permit by: [signature] date 8/26/05

Authorization to Construct by: Kelly J Cook date 7-8-05 Existing System Inspection by: date

HEALTH DEPT. COPY: WHITE OWNER COPY (FINAL): YELLOW OWNER COPY (INITIAL): PINK

Alpine Circle