IREDELL COUNTY HEALTH DEPARTMENT

STATESVILLE 704-878-5305 MOORESVILLE 704-664-5281

IMPROVEMENT PERMIT / AUTHORIZATION TO CONSTRUCT / OPERATION PERMIT / EXISTING SYSTEM INSPECTION

PERMIT# 127984 PIN# 4705315664 DATE 8-22-05

OWNER OR CONTRACTOR ~~Rick Dyson~~ → Heritage Bldg. PHONE: Business 704-902 4680 Home 704-528-6644

ADDRESS 120 Hickory PT Ct Statesville NC

LOCATION 40W to 200 mi to Alexander Knoll 1st Alpine Circle DRIVE – Property on left

SUBDIVISION Alexander Knoll BLOCK / SECTION ____ LOT 43 LOT AREA ____ SITE CLASS. ____ DESIGN FLOW 360 L.T.A.R. .3

Septic Tank: 1000 Gallons; STB 1012 Date 9-6-05

Pump Tank: ____ Gallons; PT ____ Date ____

Pump Make: ____ Model ____ Serial No. ____

Nitrification Field: No Fields ____ Square Feet 1200 Linear Feet 300

No Lines 3 Trench Width 36" Max Trench Bottom Depth 36" Gravel Depth NA

☑ New System ☐ Repair System Type: I, II, III, IV, V, VI

System Description: Gravity - 25% Rock

Repair System Description: Pump - 50%

Maintenance Agreement Required: ☐ Yes ☑ No

☑ House/Mod. Home No. Bedrooms 3

☐ Mobile Home No. Bathrooms ____

☐ Business No. Employees ____

☐ Other ____


☐ Slab ☑ Crawl Space ☐ Basement w/plumbing ☐ Basement wo/plumbing

Water Supply: ☐ Individual ☑ Public ☐ Community

Comments:/Conditions: Install on contour Maintain 25' ft of drainage Ditch along alpine circle Maintain 15' ft drainage ditch Down Property line.

Comments:/Conditions: SEPTIC TANK WITH MARKER INSTALLED USING "TUFTITE" FILTER

INITIAL SITE SKETCH

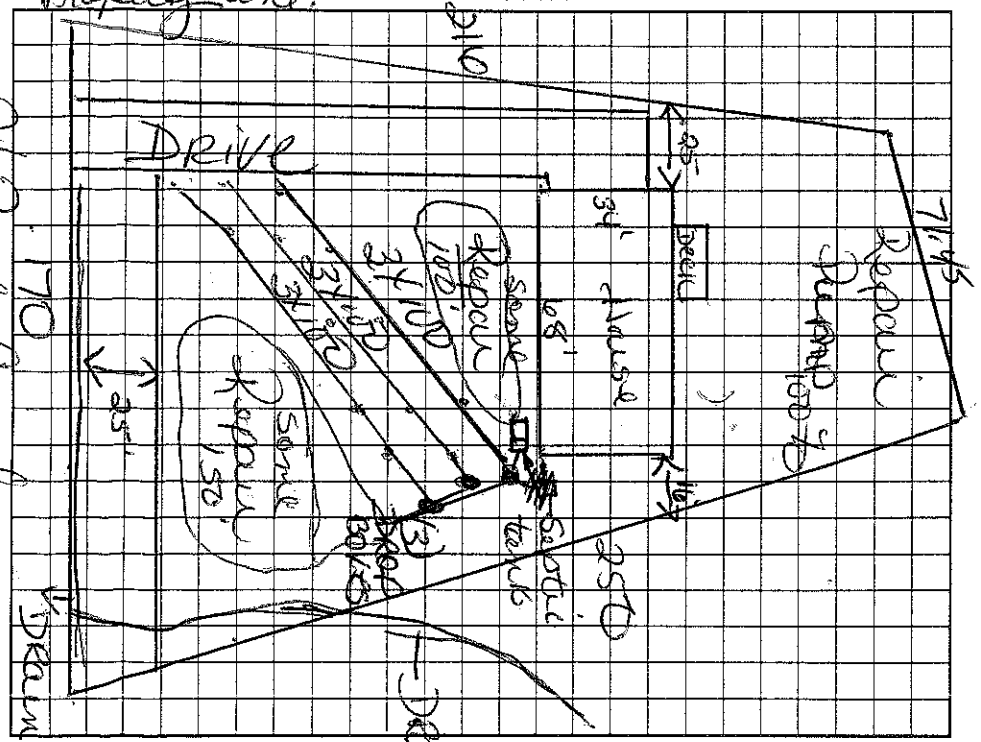

AS BUILT SKETCH

SYSTEM INSTALLED USING 15 "QUICK-4" INFILTRATOR CHAMBERS AS SHOWN

Permit can be suspended or revoked if any false information is supplied toward securing the permit/any unauthorized changes are made to the site/any unauthorized changes are made in the installation of the system. Improvement Permit with plat valid without expiration. Improvement Permit with site plan valid for sixty months. Authorization to Construct is valid for a period equal to that of Improvement Permit – not to exceed sixty months.

Signed: ____ date 9-27-05 Installed by: TOMMY FRYE

Improvement Permit by: ____ date 8-22-05 Operation Permit by: STEVE HERRICK date 9-1-06

Authorization to Construct by: ____ date 8-22-05 Existing System Inspection by: ____ date ____

HEALTH DEPT. COPY: WHITE OWNER COPY (FINAL): YELLOW OWNER COPY (INITIAL): PINK