IREDELL COUNTY HEALTH DEPARTMENT

STATESVILLE 704-878-5305 MOORESVILLE 704-664-5281

IMPROVEMENT PERMIT / AUTHORIZATION TO CONSTRUCT / OPERATION PERMIT / EXISTING SYSTEM INSPECTION

PERMIT# 126501 PIN# 4705-31-6683 DATE 4-6-05

OWNER OR CONTRACTOR HERITAGE BUILDING COMPANY - STATESVILLE PHONE: Business (704) 528-6644 Home

ADDRESS 120 HICKORY POINT COURT STATESVILLE NC 28677

LOCATION I-40W TR OMR TR ALPINE CIR. LOT ON LEFT

SUBDIVISION ALEXANDER'S KNOLL BLOCK / SECTION LOT 44 LOT AREA 0.567 SITE CLASS. PS DESIGN FLOW 360 L.T.A.R. 0.30 gpd/ft²

Septic Tank: 1000 Gallons; STB 1012 Date 3-1-05
Pump Tank: Gallons; PT Date
Pump Make: Model Serial No.
Nitrification Field: No Fields 1 Square Feet 1200 Linear Feet 300'
No Lines 4 Trench Width 36" Max Trench Bottom Depth 24" Gravel Depth N/A

☑ New System ☐ Repair System Type: I, II, (III) IV, V, VI
System Description: GRAVITY 25% REDUCTION
Repair System Description: LOW-PRESSURE PIPE
Maintenance Agreement Required: ☐ Yes ☑ No

☑ House/Mod. Home No. Bedrooms 3
☐ Mobile Home No. Bathrooms
☐ Business No. Employees
☐ Other
☐ Slab ☑ Crawl Space ☐ Basement w/plumbing ☐ Basement wo/plumbing


Water Supply: ☐ Individual ☑ Public ☐ Community

Comments:/Conditions: (1) INSTALL LINES 24" ON CONTOUR (2) SMOOTH OUT ROUGH TOPOGRAPHY (3) MAINTAIN ALL SETBACKS

Comments:/Conditions: Yellow Tape - Site Inspection Stake Marker

XSCALE 1"=40'

INITIAL SITE SKETCH 225'

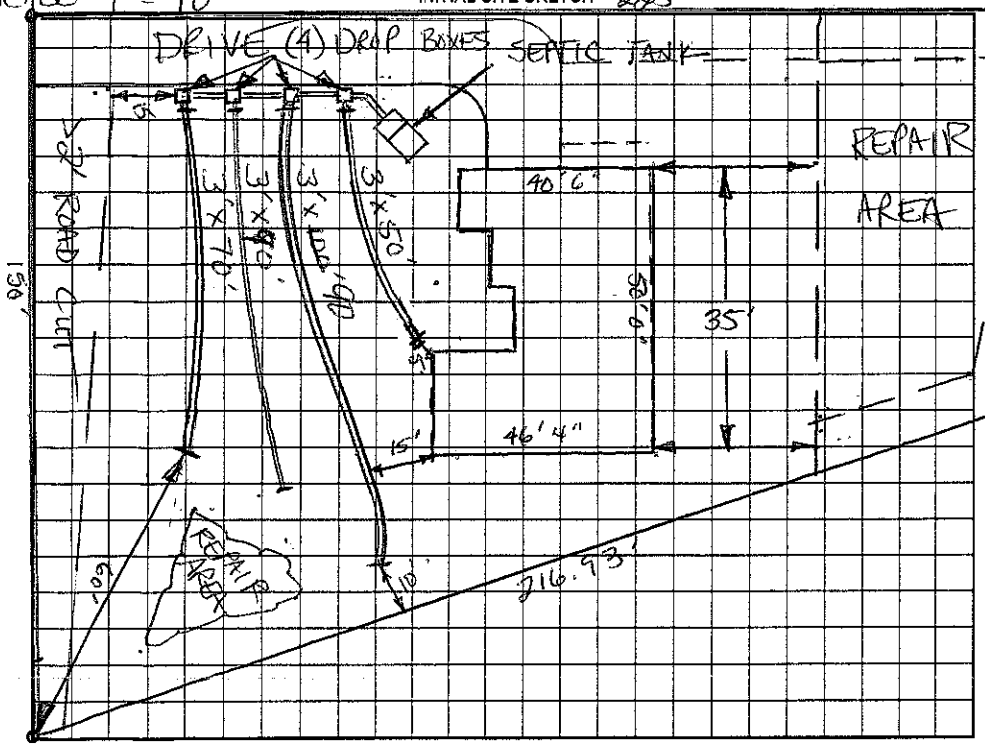

AS BUILT SKETCH

Permit can be suspended or revoked if any false information is supplied toward securing the permit/any unauthorized changes are made to the site/any unauthorized changes are made in the installation of the system. Improvement Permit with plat valid without expiration. Improvement Permit with site plan valid for sixty months. Authorization to Construct is valid for a period equal to that of Improvement Permit – not to exceed sixty months.

Signed: date 4-13-05 Installed by: Tommy Frye

Improvement Permit by: Christopher M. Sherrill RS, LSS date 4-6-05 Operation Permit by: date 8-25-05

Authorization to Construct by: Christopher M. Sherrill RS, LSS date 4-6-05 Existing System Inspection by: date

HEALTH DEPT. COPY: WHITE OWNER COPY (FINAL): YELLOW OWNER COPY (INITIAL): PINK